


T.29S. R.12W. W.M.

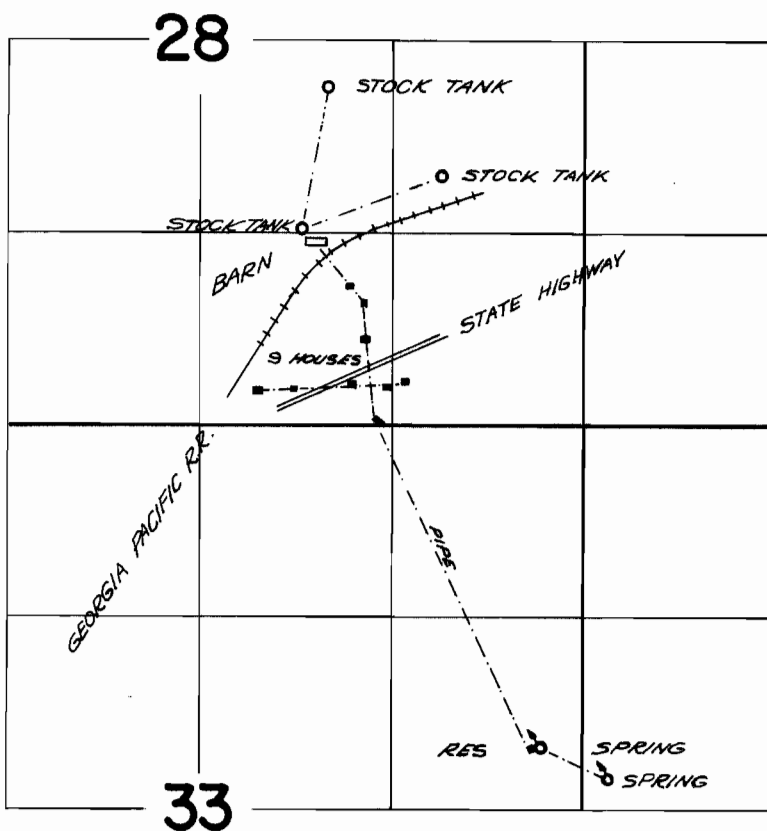

Springs located 420 ft N of 280 ft W. ; 200 ft N. of 180 ft E from the E $\frac{1}{4}$ cor. section 33

FINAL PROOF SURVEY UNDER

Application No. 39912 Permit No. 29707

IN NAME OF

PAUL and KATHRYN WILEY, H. B. GILPATRICK, DALE HOFFMAN
MRS. F. C. HOFFMAN, M. M. LAMBART, and R. M. WARNER

Surveyed Oct 5 1966, by V. GARNER