


T. 41 S. R. 13 W. WM.

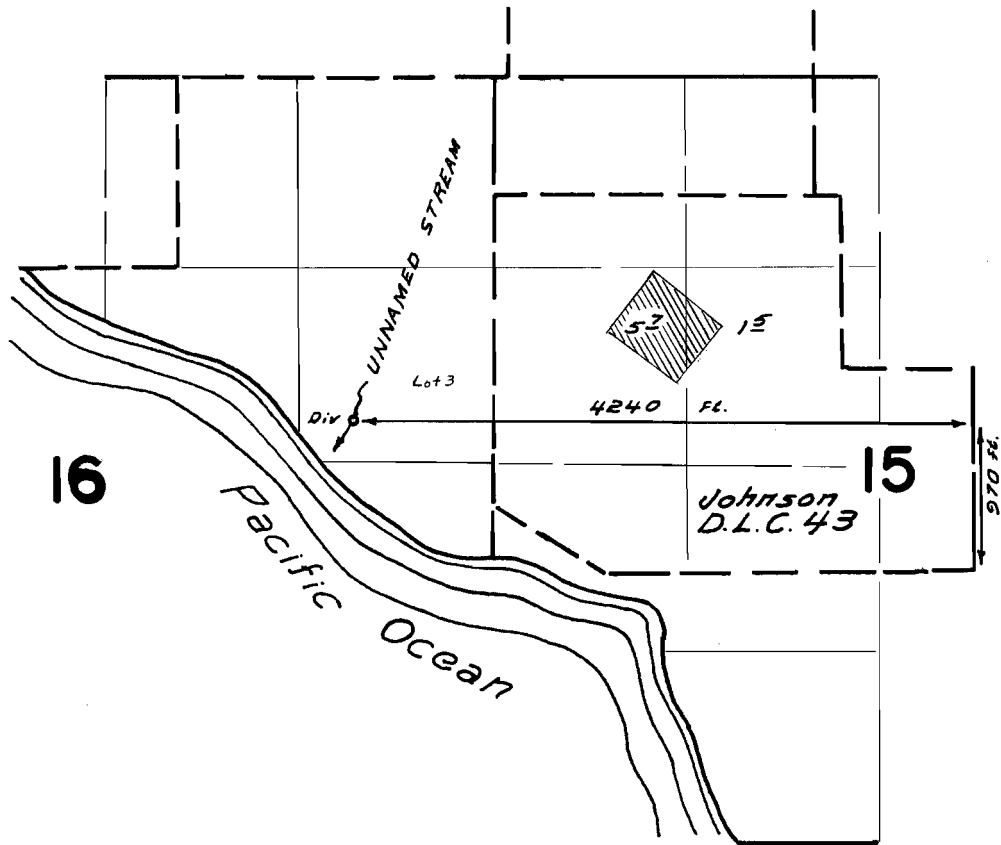

FINAL PROOF SURVEY
UNDER

Application No. 39927 Permit No. 29718
IN NAME OF

A. K. Hastings

Surveyed Sept 15 1966, by W. J. Ruppert