


T.36 S. R.14 W. W.M.

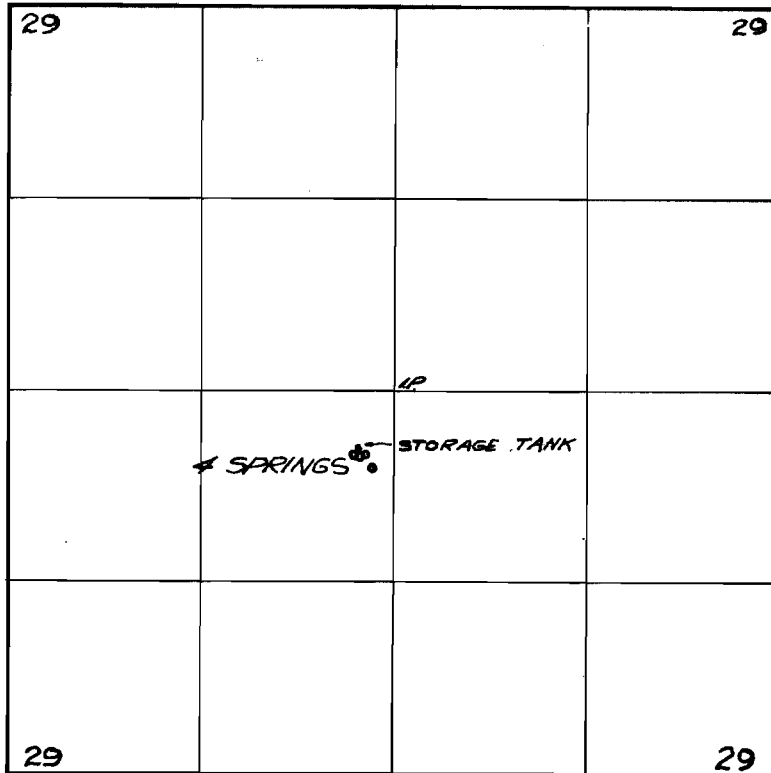

Springs located 530 ft. S. & 140 ft. W. ; 440 ft. S. & 190 ft. W. ; 450 ft. S. & 220 ft. W. ; 440 ft. S. & 280 ft. W., all from the center of Section 29

FINAL PROOF SURVEY UNDER

Application No. 32335 Permit No. 25512
IN NAME OF

JOHN A. RATZEBURG

Surveyed Sept. 19, 1966, by V. GARNER