


T.14S. R.31E.W.M.

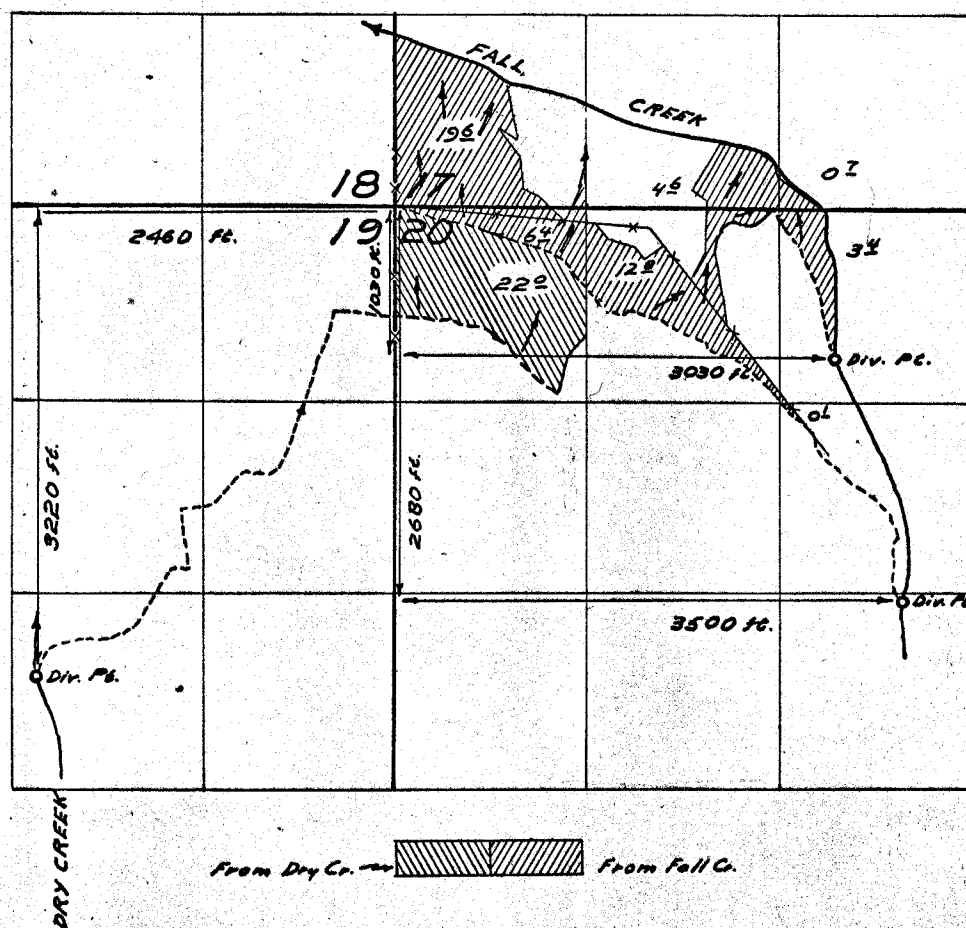

FINAL PROOF SURVEY UNDER

Application No. 37164 Permit No. 27679
IN NAME OF

James A. Wyllie

Surveyed June 6 1966 by W. J. Ruppert