


T.34 & 35S.R.3W. W.M.

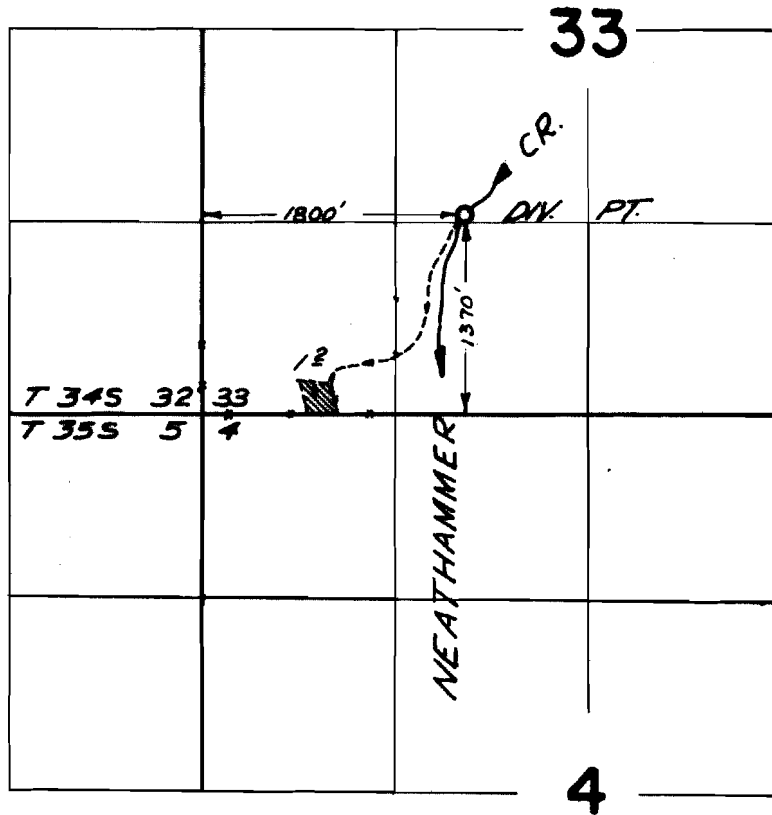

FINAL PROOF SURVEY UNDER

Application No. 40867 Permit No. 30466
IN NAME OF

Don L. Fowler, Don A. Fowler, & Jean C. Fowler

Surveyed *July 20* 1966, by *V. GARNER*....