


T.35S.R.1W. W.M.

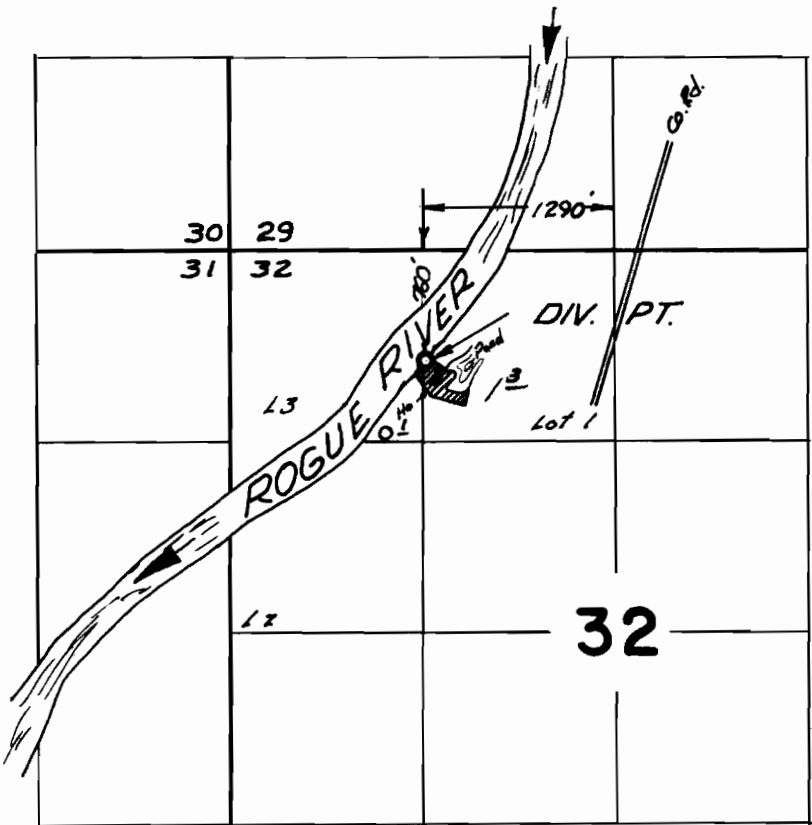

FINAL PROOF SURVEY
UNDER

Application No. 40258 Permit No. 30016
IN NAME OF

JACK K. JAMES

Surveyed July 21, 1966, by V. GARNER