


T35SR2WWM

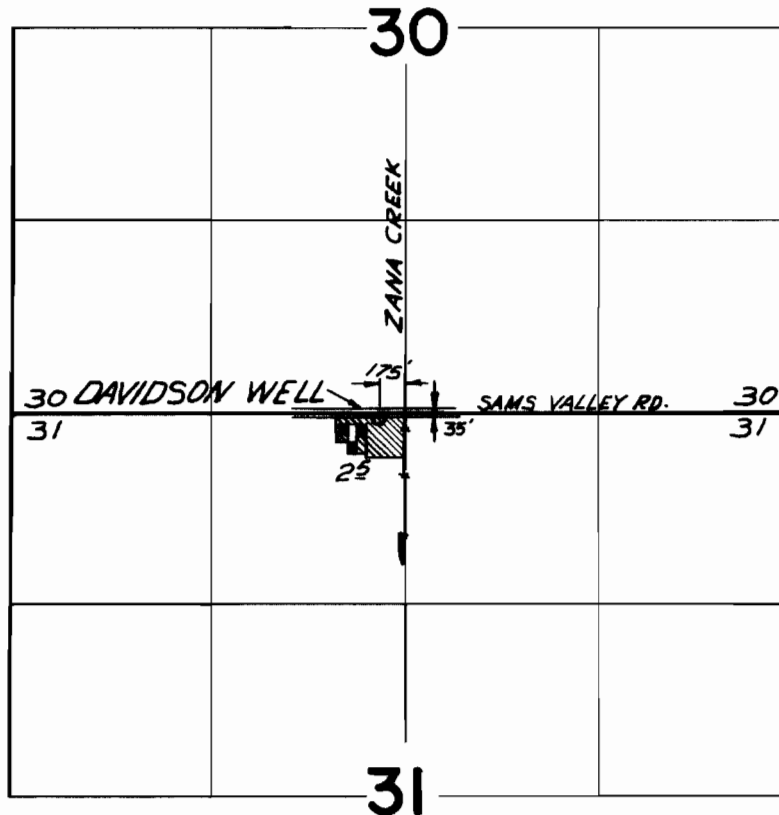

FINAL PROOF SURVEY
UNDER

Application No. G.2513 Permit No. G.2321
IN NAME OF

DALE P. SCHULZ

Surveyed July 20, 1966, by V. GARNER