G-700
3d 518

T. 38 S. R. 10 E. W.M.

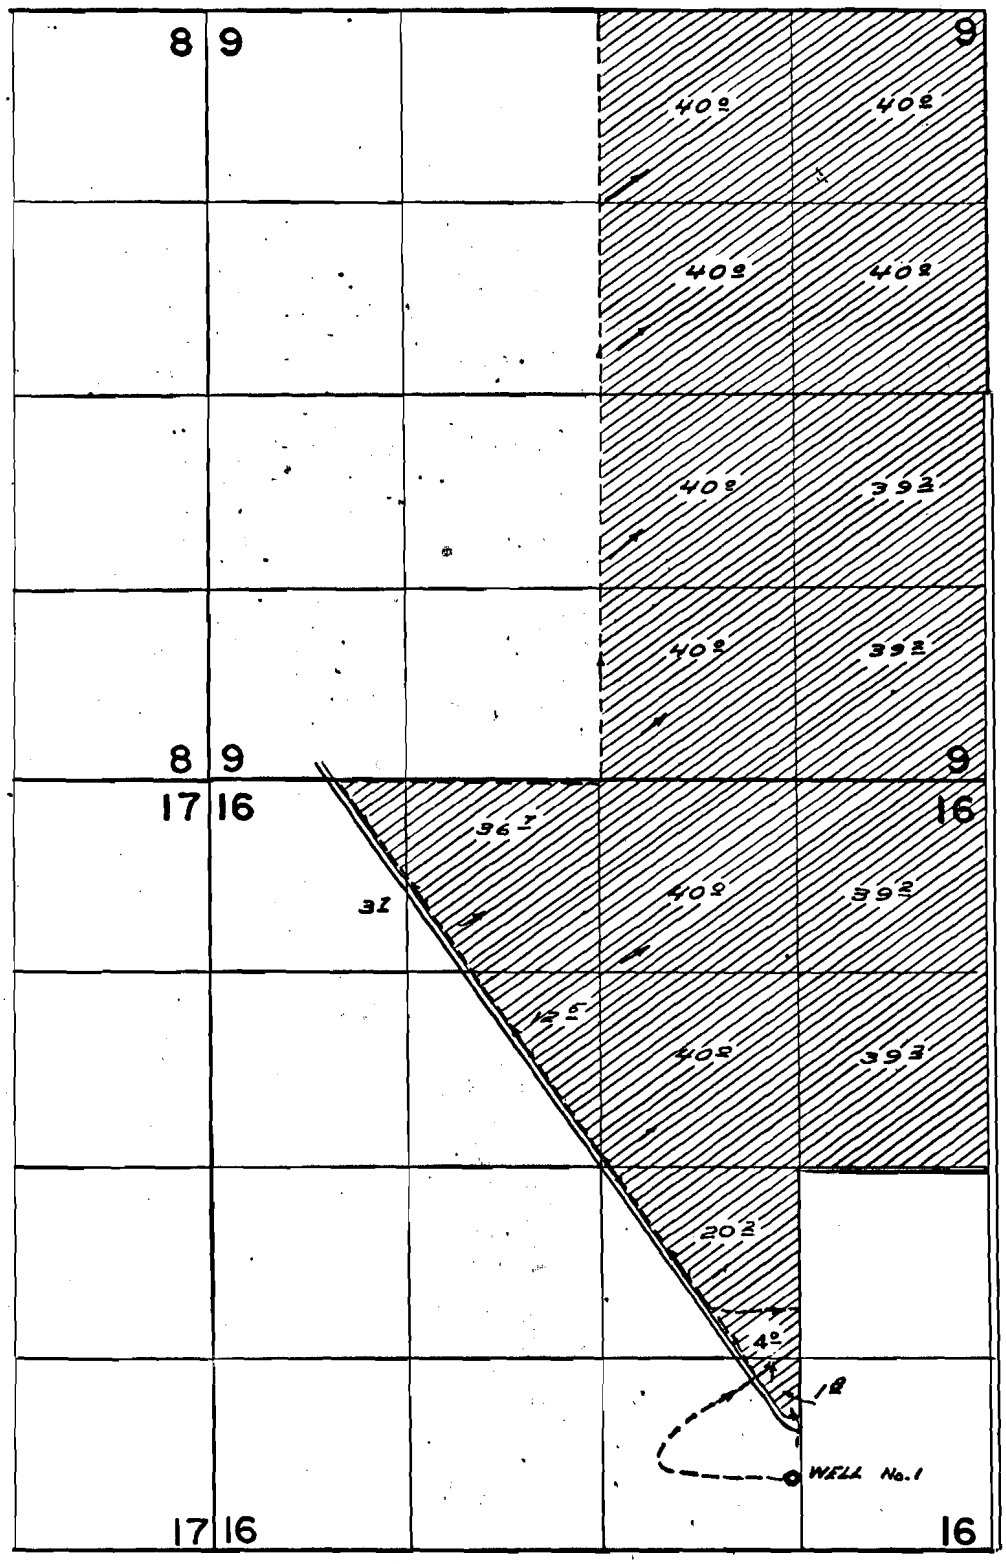

Well located 2120 ft S. & 60 ft. W. from N.W. Cor. N.E. 1/4 S.E. 1/4 Sec. 16.

FINAL PROOF SURVEY

UNDER

APPLICATION NO. G-762 PERMIT NO. G-700

IN NAME OF

MAUDE E. LISKEY

SURVEYED OCT. 4 & 5, 1966 BY W. J. Ruppert

Swan Lake Wells