Swan Lake Well

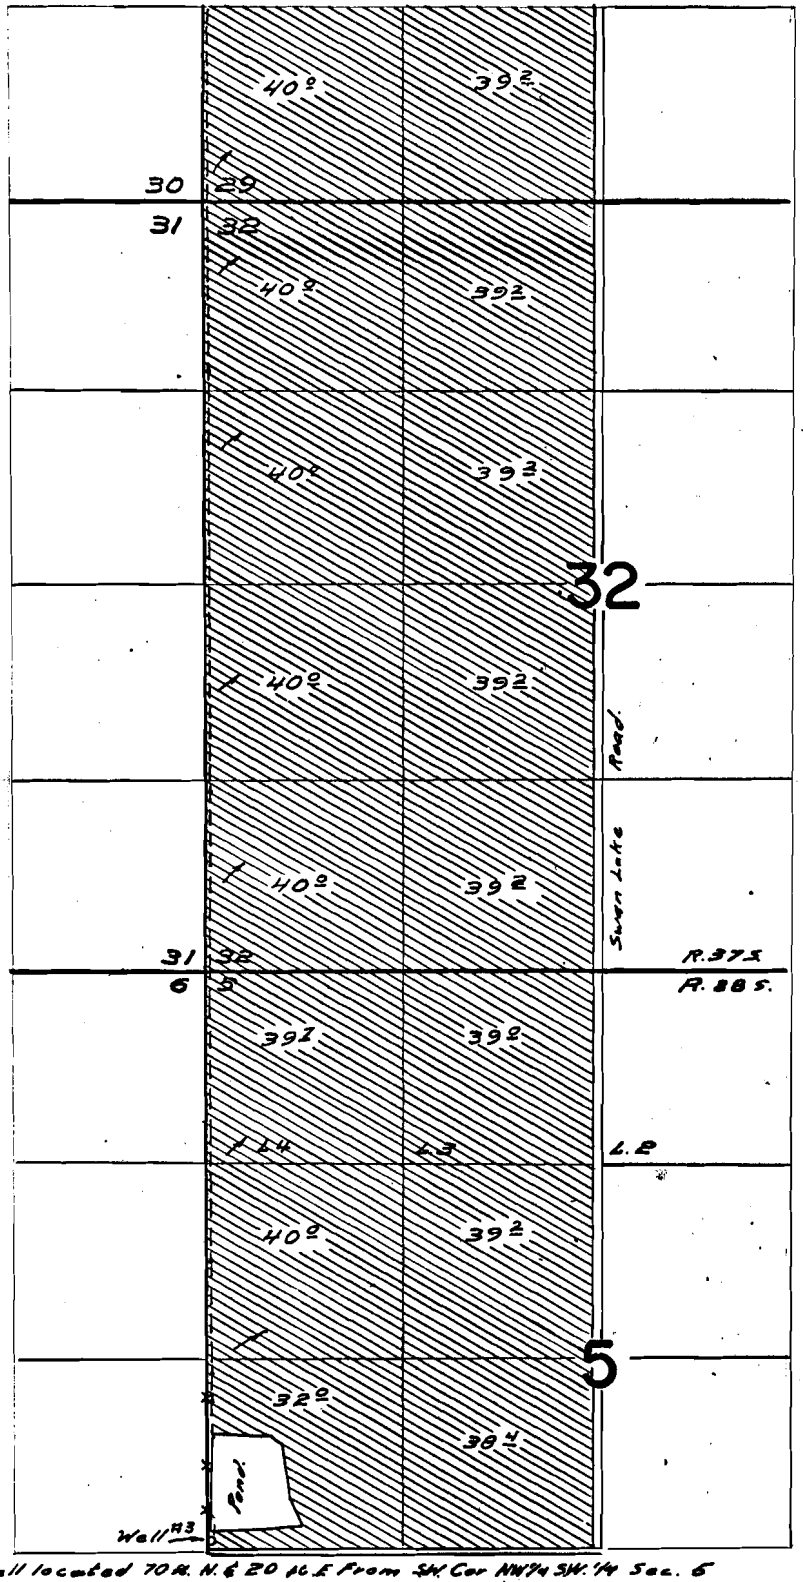

Well located 70 ft. N. & 20 ft. E. from SW. Cor NW¼ SW.¼ Sec. 6

FINAL PROOF SURVEY

UNDER

APPLICATION NO. G-856 PERMIT NO. G-764

IN NAME OF

MAUDE E. LISKEY

SURVEYED OCT. 4 & 5, 1966 BY W. J. Rupert

PTS-1966-N
CHO-61-K-45-47