


T.19S.R.3W.W.M.

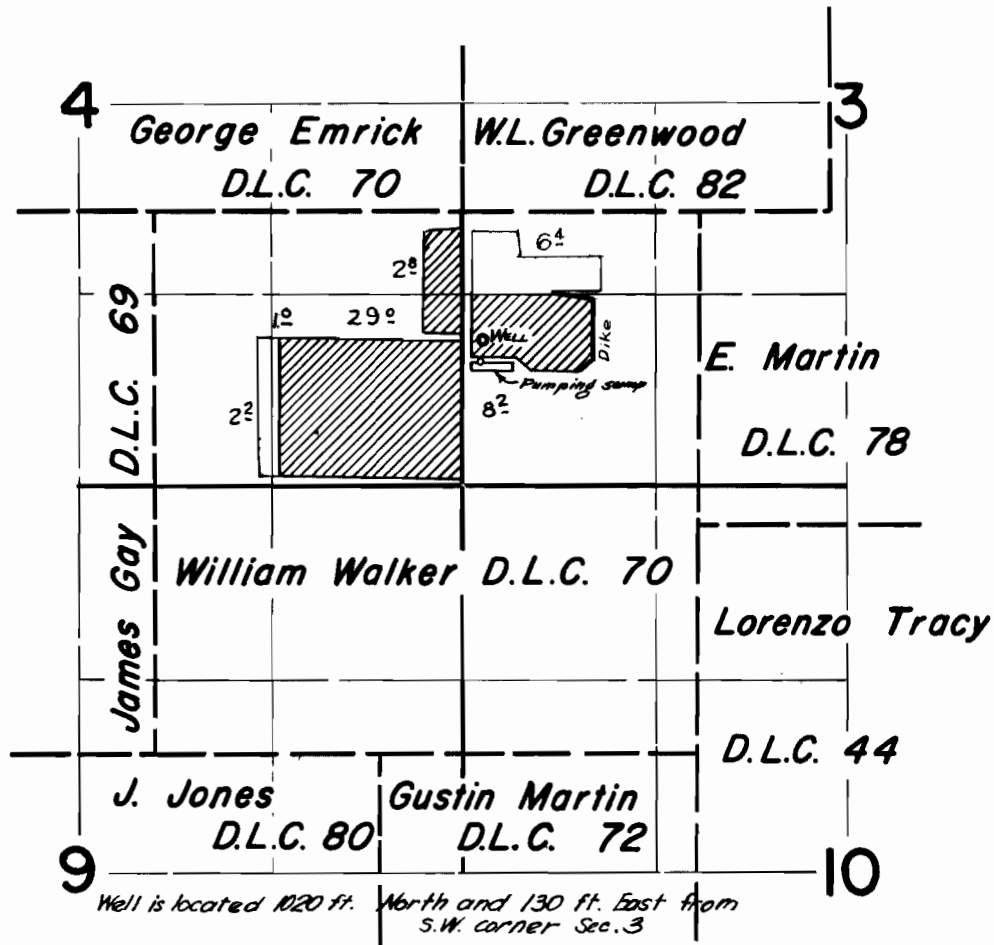

FINAL PROOF SURVEY
UNDER

Application No. G-2477 Permit No. G-2288
IN NAME OF
OREGON STATE GAME COMMISSION

Surveyed April 27 1965, by

[Signature]