


T.5S.R.2W.W.M.

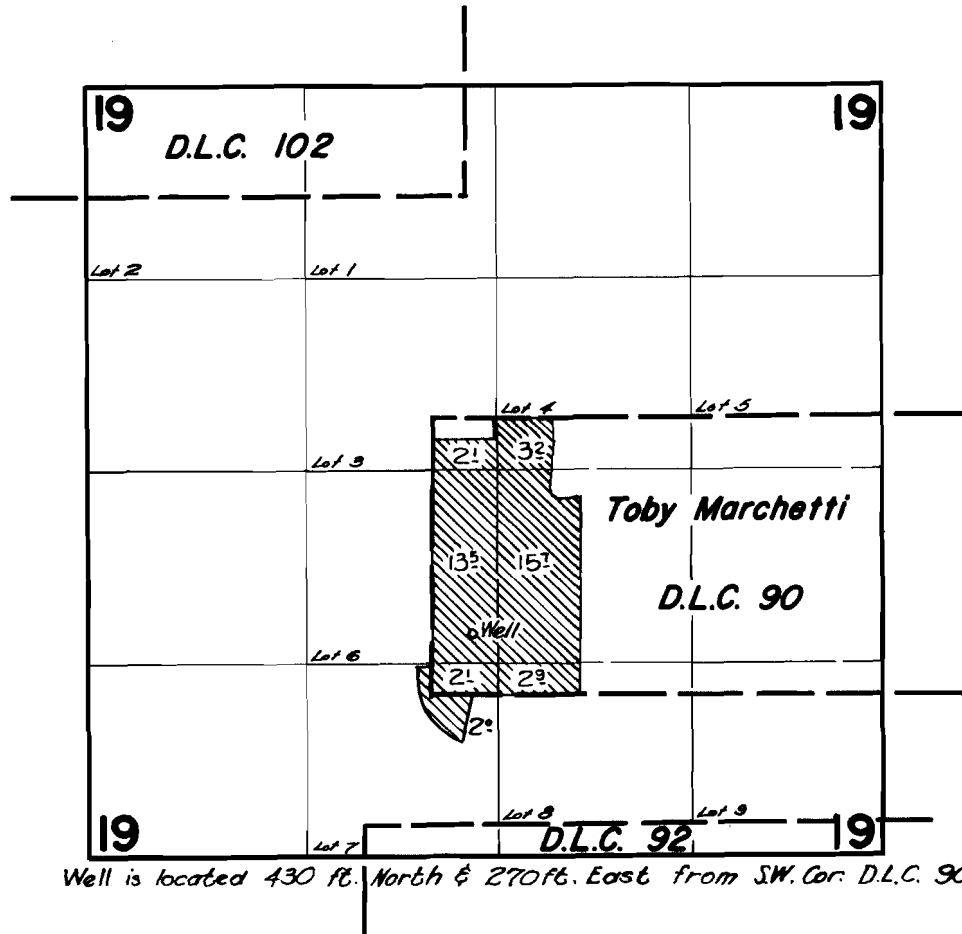

FINAL PROOF SURVEY UNDER

Application No. G-1604 Permit No. G-1476
IN NAME OF

RICHARD PECH & ILSE PECH

Surveyed June 3, 1965, by *R. Pech*