


T.1S.R.25E.W.M.

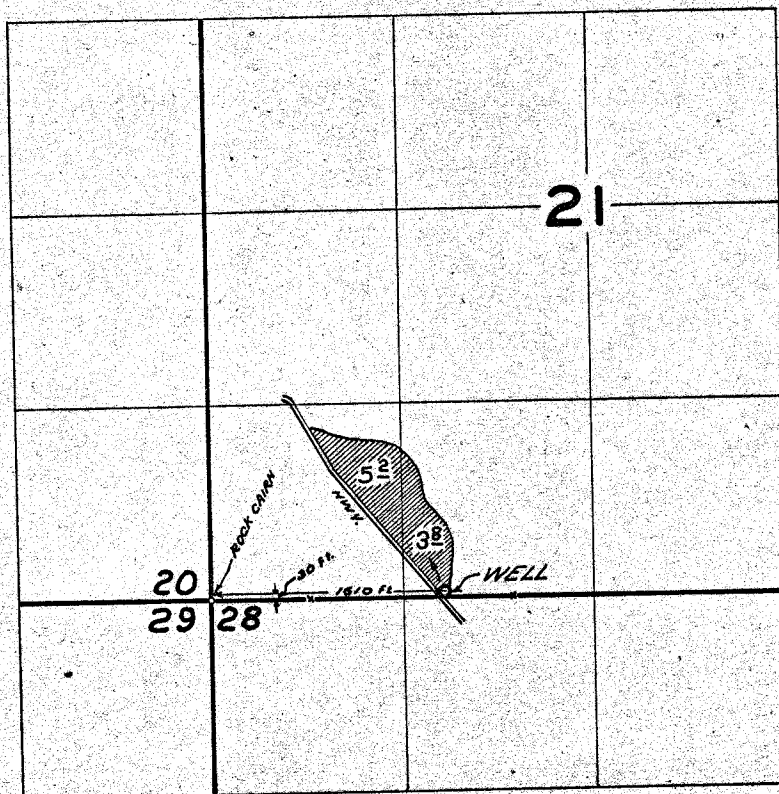

FINAL PROOF SURVEY UNDER

Application No. G-1238 Permit No. G-1781
IN NAME OF

O. W. CUTSFORTH

Surveyed Aug. 3, 1966, by L. GOULD