


T. 26 S. R. 46 E. W. M.

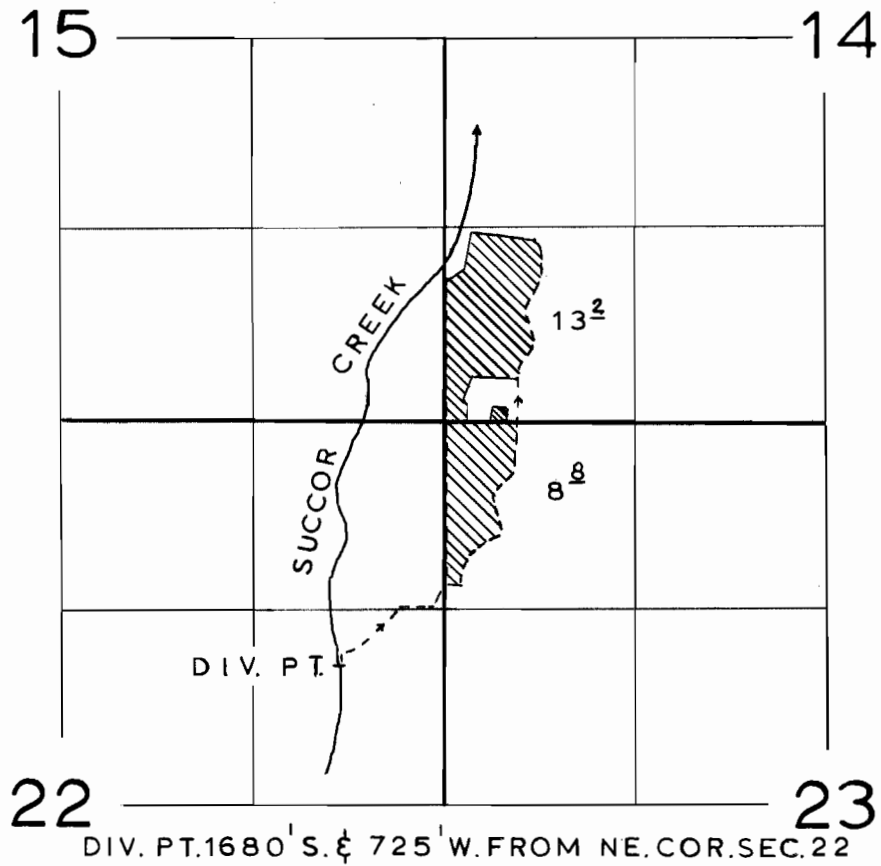

FINAL PROOF SURVEY
UNDER

Application No. 38973 Permit No. 29038
IN NAME OF

ELIZABETH MAC IVER

Surveyed OCT. 28, 1966, by F. ELFERING