


25326
(DIU. PTS)

T.4S. R.10E. W.M.

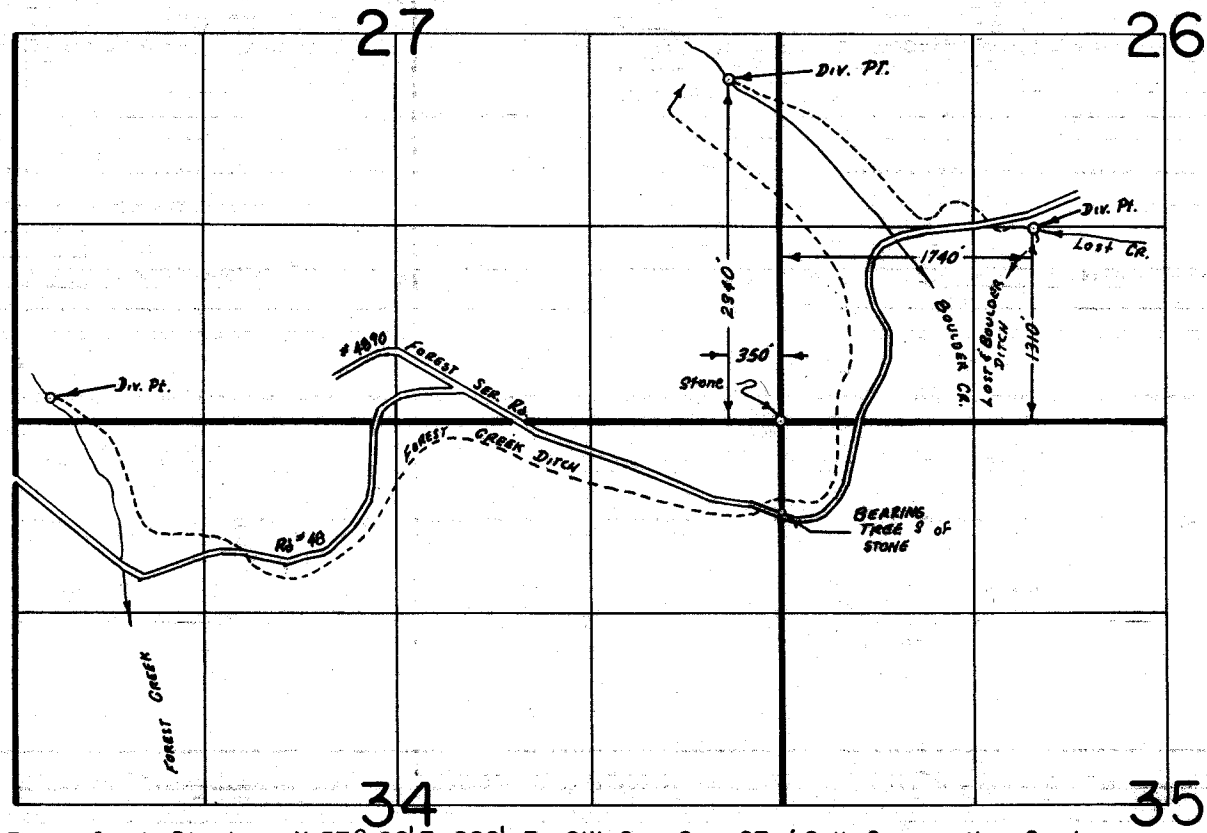

Forest Creek Div. Loc. N 57° 02' E 282' Fr. SW Cor. Sec. 27 (Soil Conservation Service Survey Jan 17, 1958)

FINAL PROOF SURVEY UNDER

Application No. _____ Permit No. _____
IN NAME OF

LOST & BOULDER DITCH CO.

Surveyed Aug. 9 1983, by T. J. Paul