


T.5 S.R.2 W. W.M.

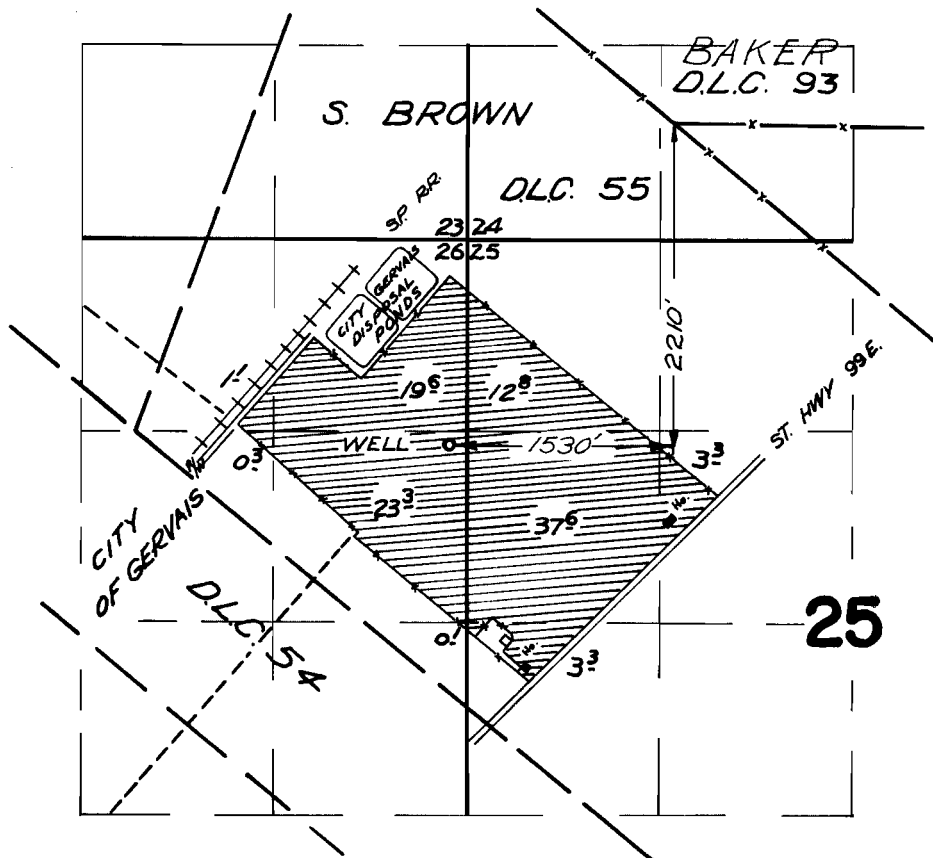

FINAL PROOF SURVEY UNDER

Application No. G-2763 Permit No. G-2566
IN NAME OF

RALPH DUDA

Surveyed Sept. 30 1966, by V. GARNER