


T. 7 S. R. 39 E. W. M.

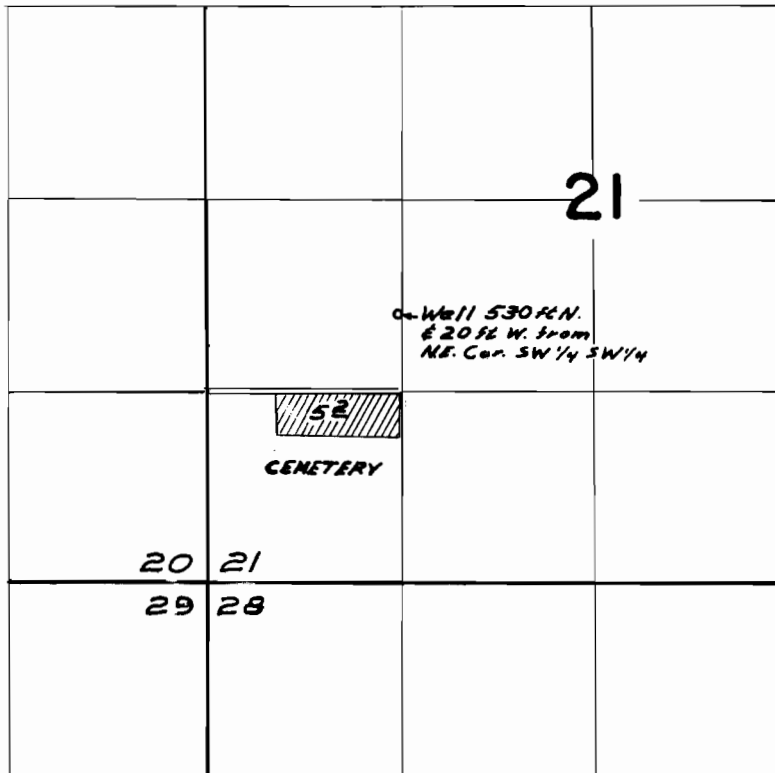

FINAL PROOF SURVEY
UNDER

Application No. G-2414 Permit No. G-2281
IN NAME OF

Haines Cemetery Maintenance Dist

Surveyed Aug. 8, 1966, by W.J. Ruppert