


T.14 S. R. 6 W. W.M.

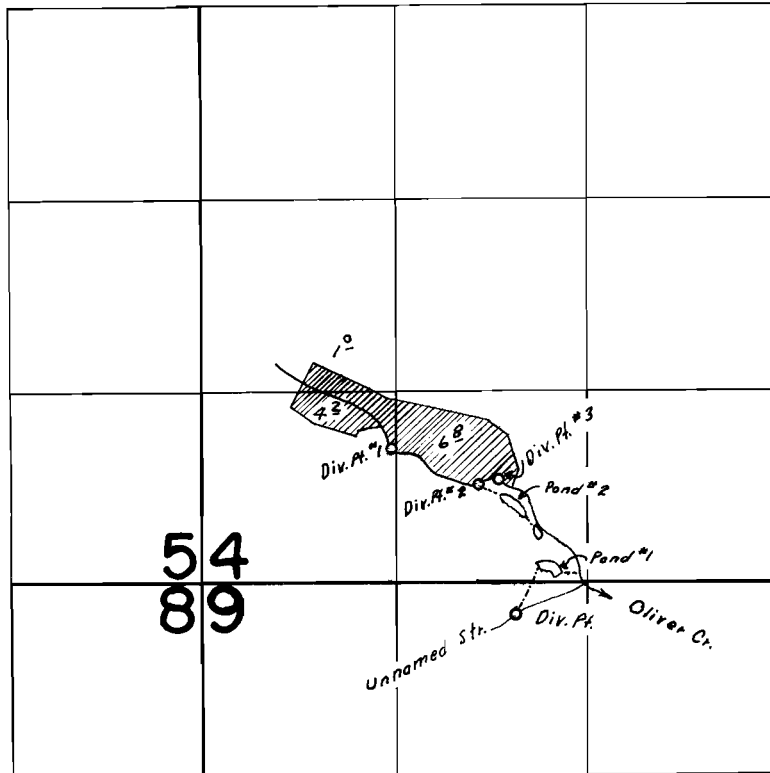

Oliver Creek Div. pts.
 *1 - 925ft. N. & 1330ft. W.
 *2 - 660ft. N. & 730ft. W.
 *3 - 700ft. N. & 600ft. W. } From the S. 1/4 corner
 of Section 4
 Unnamed Stream Div. Pt. is 225 ft. S. & 490 ft. W.
 of the S. 1/4 Corner of Section 4

FINAL PROOF SURVEY UNDER

R-26955 R-1342
 Application No. 26956 Permit No. 21177
 IN NAME OF

ALLAN or BUNNY COOK

Surveyed Sept. 30, 1966, by C.J. Gardner