


T.5S.R.1E.W.M.

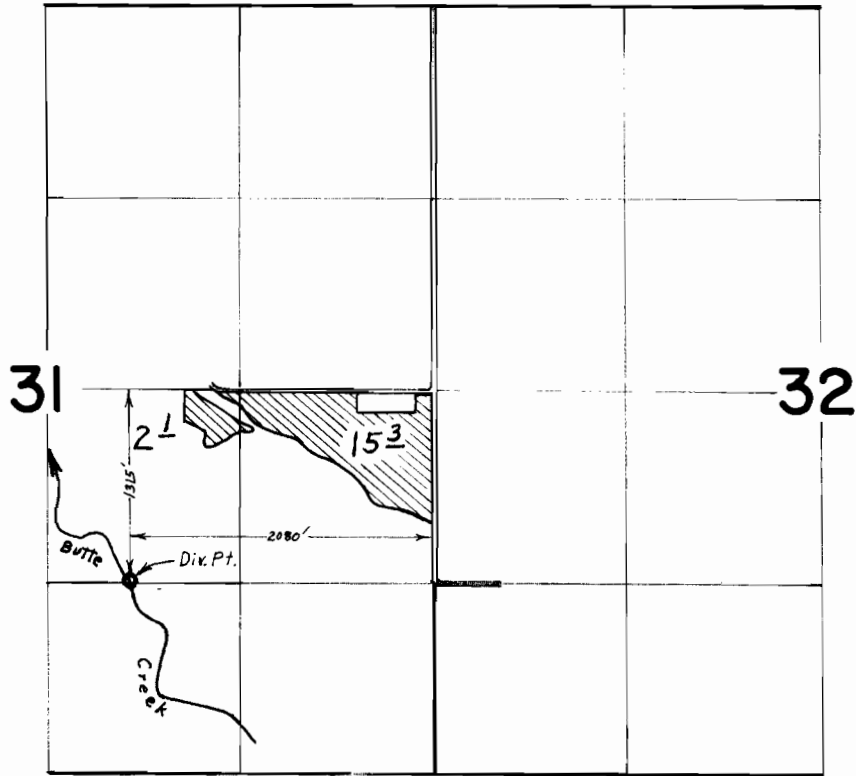

FINAL PROOF SURVEY
UNDER

Application No. 37209 Permit No. 27779
IN NAME OF

VINCENT M. BEYER

Surveyed Sept. 30 1966, by L. E. Gould