


T. 3 & 4 S. R. 1 E. W. 6

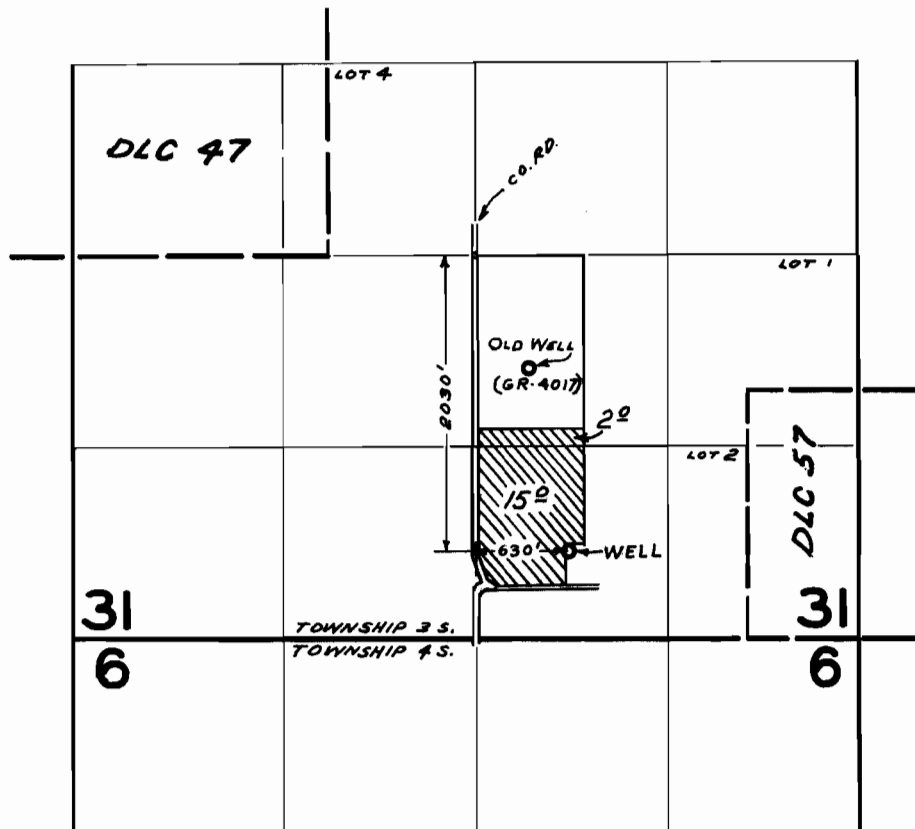

FINAL PROOF SURVEY UNDER

Application No. G-2617 Permit No. G-2428
IN NAME OF

BERT GARRE

Surveyed Aug 10, 1964, by C. GARDNER
APR 23, 1965 R. JACKSON