


T.5S.R.1E.W.M.

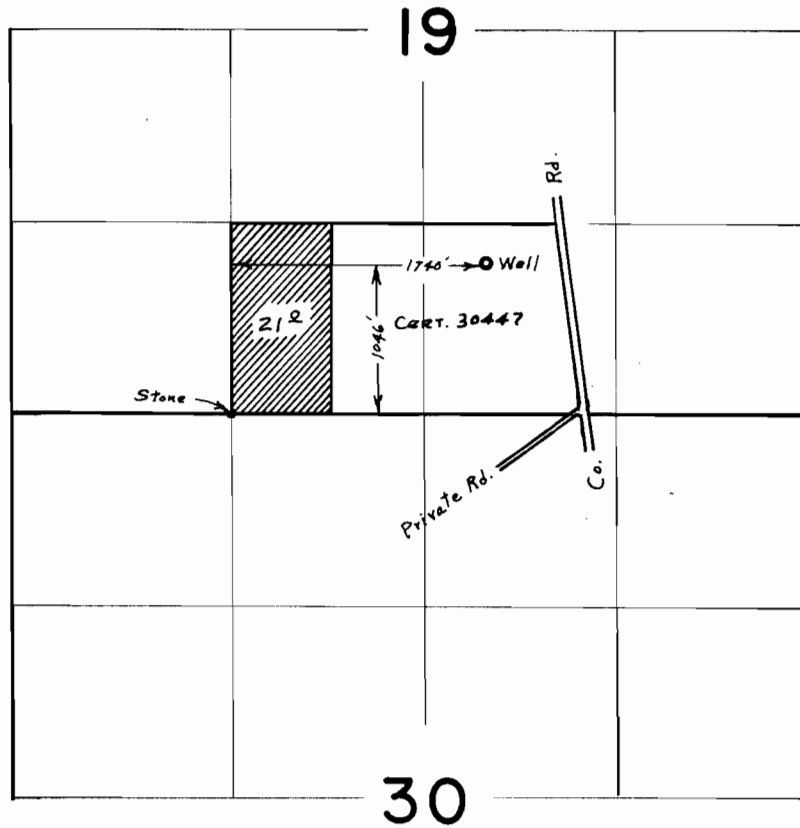

FINAL PROOF SURVEY
UNDER

Application No. G-2382 Permit No. G-2227
IN NAME OF
VICTOR F. JOSI

Surveyed Sept. 29, 1966, by L. E. Gould