


T. 4 S. R. 4 E. W. M.

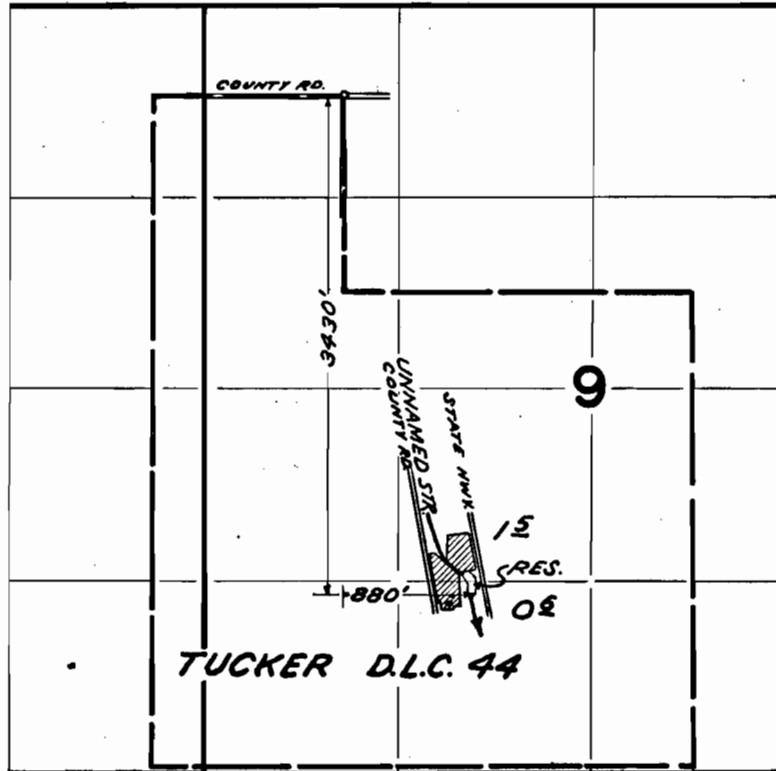

**FINAL PROOF SURVEY**  
UNDER

Application No. R-37165 37016 Permit No. R-2699 27645  
IN NAME OF

WILLARD J. REED

Surveyed APR. 15 1965, by R. JACKSON