


T.35 & 36 S. R.14 W. WM.

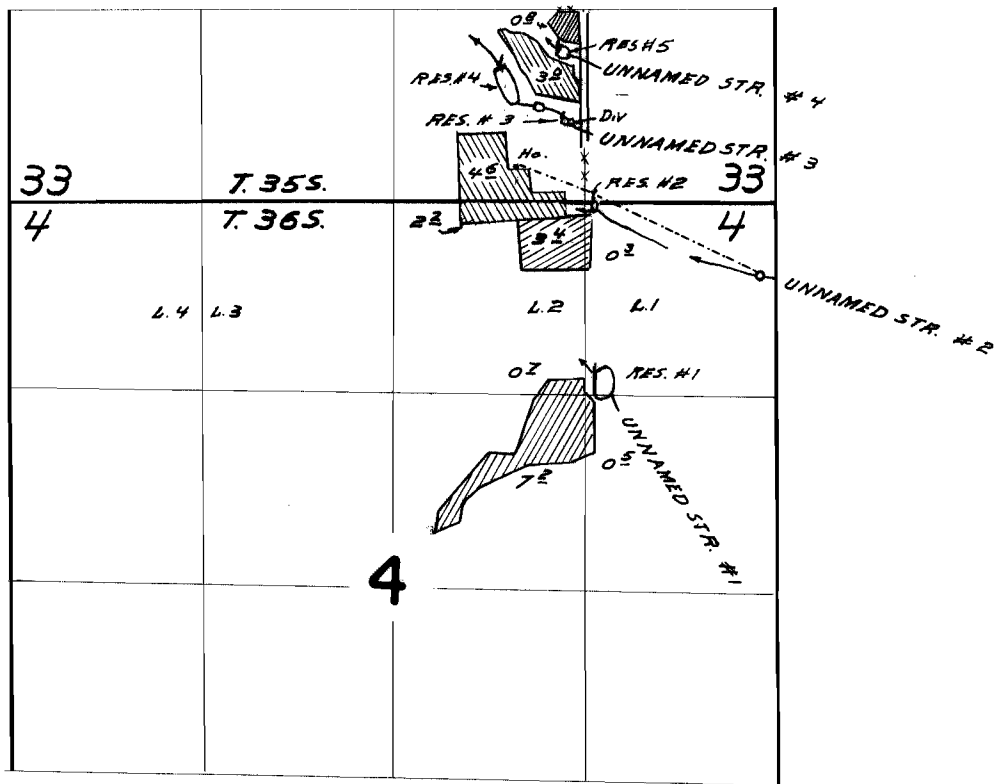

DIVERSION POINTS LOCATED FROM NE COR SW 1/4 SE 1/4 SEC. 33
 270 ft. S. & 160 ft. W.; 400 ft. S. & 580 ft. W.; 660 ft. S. & 340 ft. W.;
 770 ft. S. & 80 ft. W.; 1380 ft. S. & 80 ft. E.; 1830 ft. S. & 1200 ft. E.; &
 2490 ft. S. & 60 ft. E.

FINAL PROOF SURVEY UNDER

Application No. 39802 7-40345 Permit No. 30259 7-4547
 IN NAME OF

O. P. Ferguson

Surveyed Sept. 22 1966, by W. J. Ruppert