


T.35 & 36 S. R.14 W. WM.

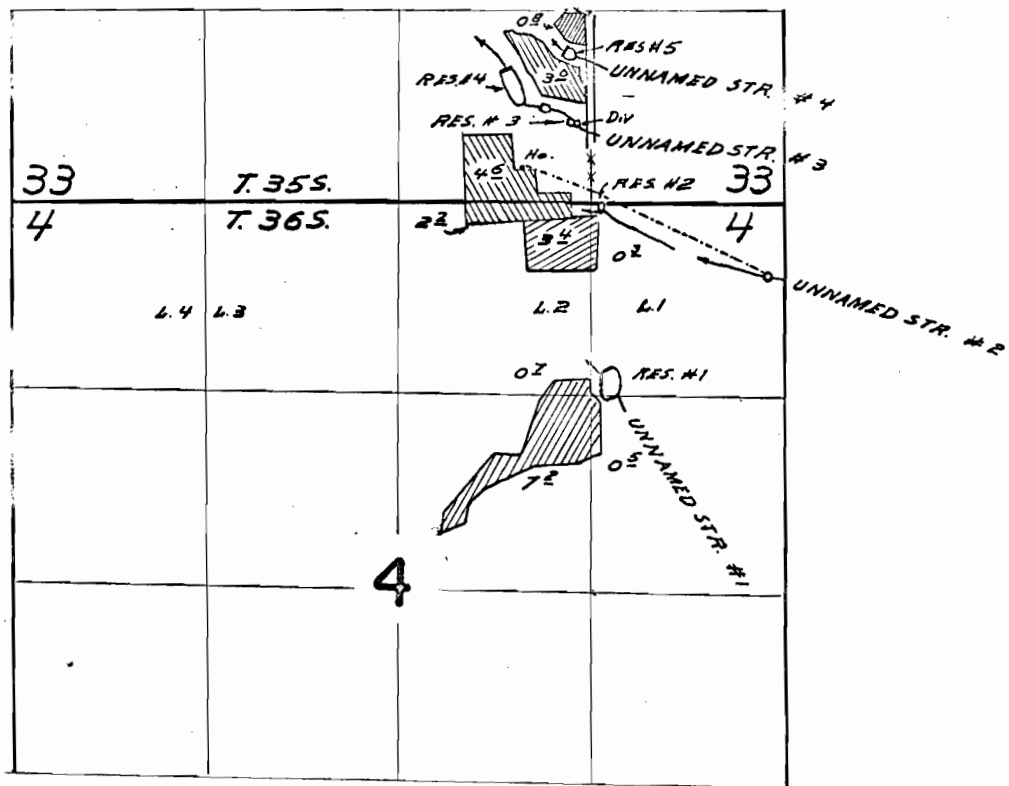

DIVERSION POINTS LOCATED FROM NE COR SW 1/4 SE 1/4 SEC. 33  
 270 ft. S. & 160 ft. W.; 400 ft. S. & 580 ft. W.; 660 ft. S. & 340 ft. W.;  
 770 ft. S. & 80 ft. W.; 1380 ft. S. & 80 ft. E.; 1830 ft. S. & 1200 ft. E.; &  
 2490 ft. S. & 80 ft. E.

## FINAL PROOF SURVEY UNDER

Application No. 39802 Permit No. 30259  
R-40345 IN NAME OF R-4547

O. P. Ferguson

Surveyed Sept. 22 1966, by H. J. Ruppert