


T.38S. R.14W. W.M.

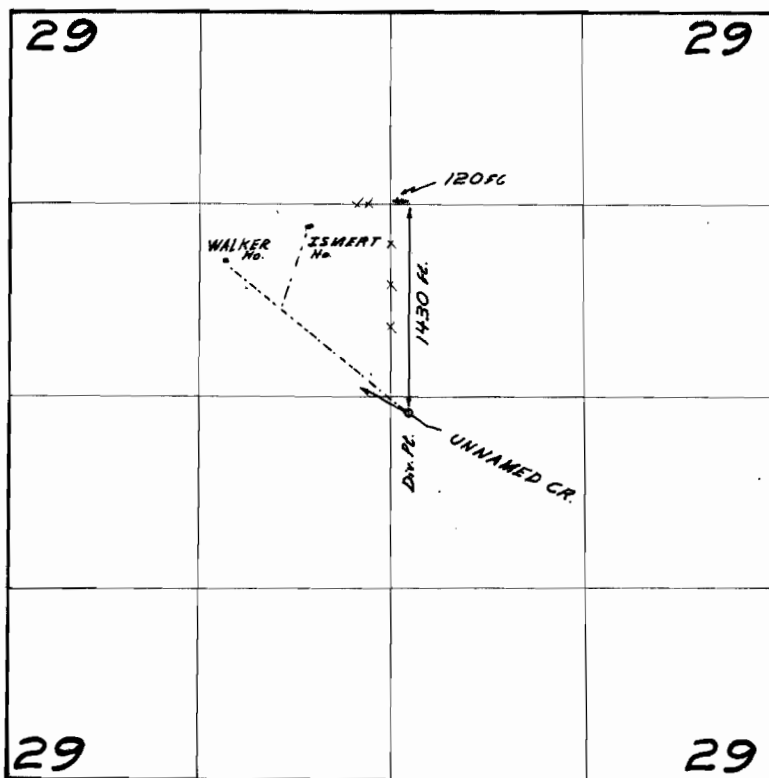

**FINAL PROOF SURVEY**  
UNDER

Application No. 39817 Permit No. 29590  
IN NAME OF

EDITH ISMERT & MURRAY WALKER

Surveyed Sept 19 1966, by W. J. Ruppert