


T.27S.R.5W.W.M.

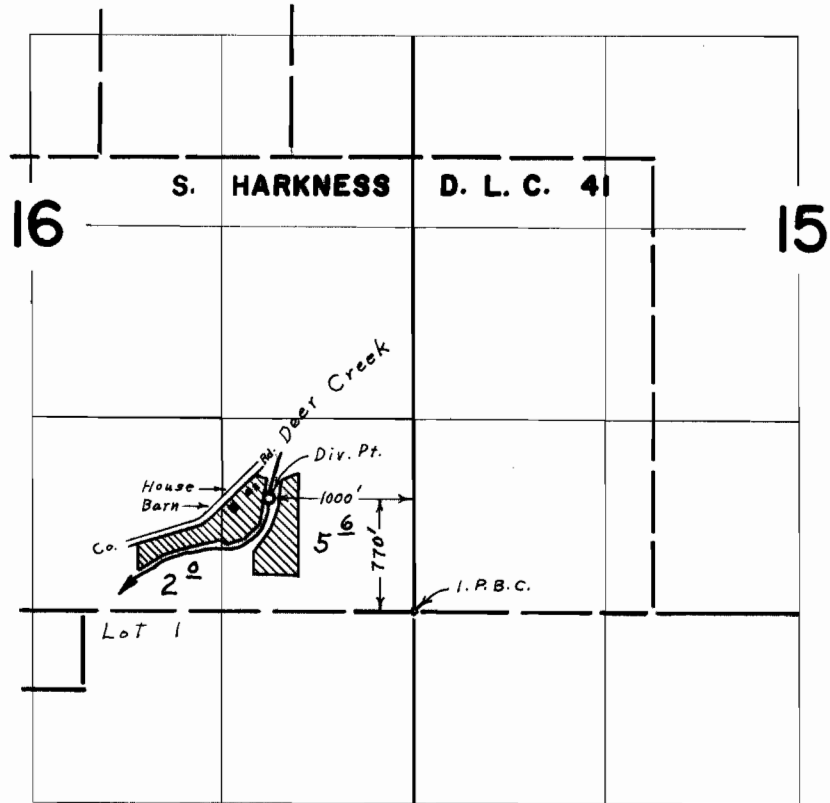

(Permit No. 6740 - 1st Acre, S.E. $\frac{1}{4}$, S.E. $\frac{1}{4}$, Sec. 16)

FINAL PROOF SURVEY UNDER

Application No. 38760 Permit No. 28993
IN NAME OF

CHARLES D. & SHIRLEY ANN COLEGROVE

Surveyed June 12, 1967, by L. E. Gould