


T. 21 S. R. 4 W. W.M.

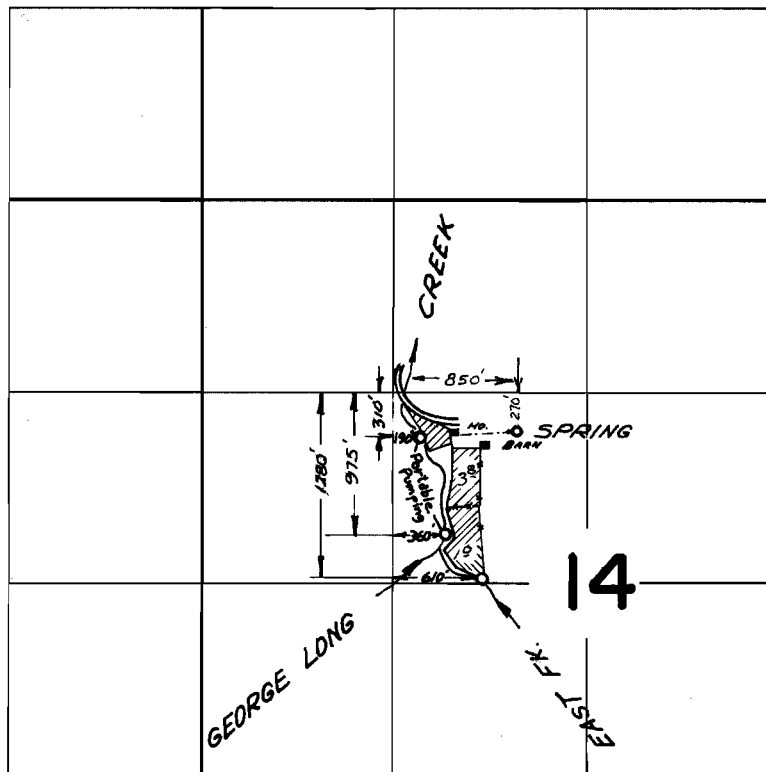

FINAL PROOF SURVEY
UNDER

31687 25821
Application No. 32835 Permit No. 25913
IN NAME OF

JAMES BAXTER DAVIS

Surveyed May 16 1966, by V. R. GARNER