


T. 21 S. R. 4 W. W.M.

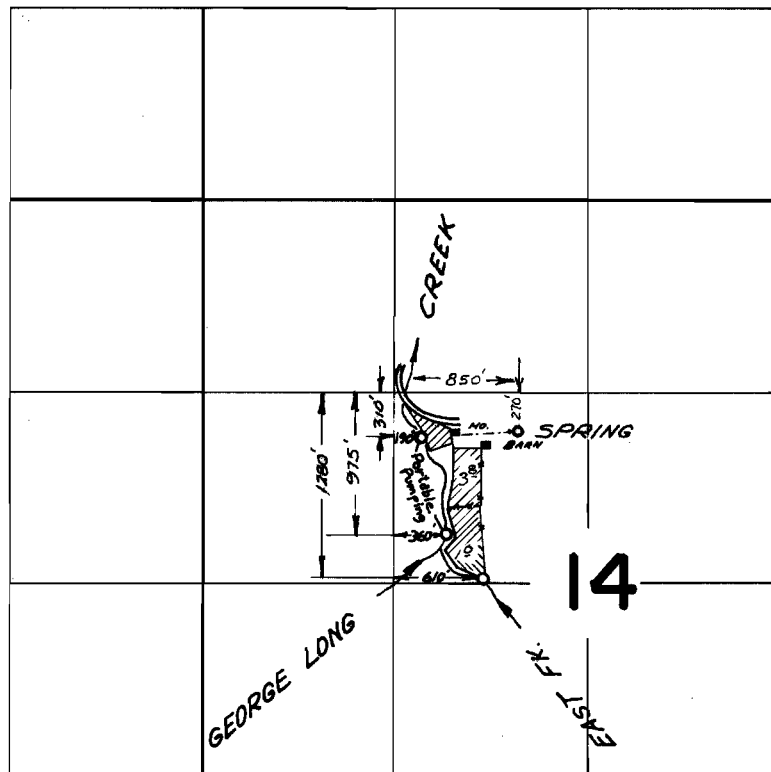

FINAL PROOF SURVEY
UNDER

Application No. 32835 ^{3/687} Permit No. 259/3 ²⁵⁸²¹
IN NAME OF

JAMES BAXTER DAVIS

Surveyed May 16 1966, by V. R. GARNER