


T.18S.R. 42E.W.M.

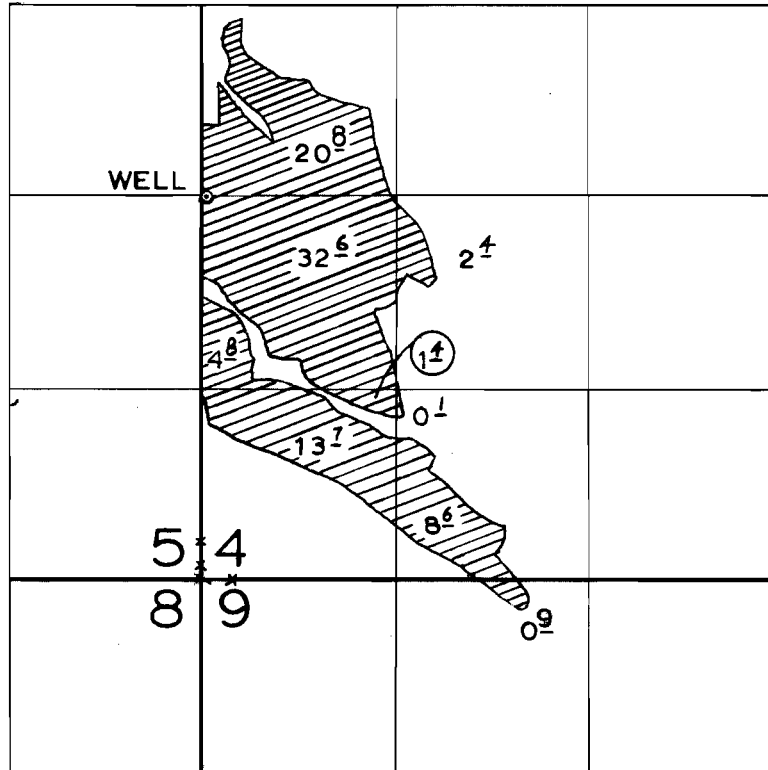

DIV. PT. 2640' N. & 9' E. FROM SW. COR. SEC. 4

FINAL PROOF SURVEY
UNDER

Application No. G-2205. Permit No. G-2133
IN NAME OF

RICHARD JORDAN

Surveyed FEB. 18, 1966, by E. ELFERING