


T.18 S.R. 45 E.W.M.

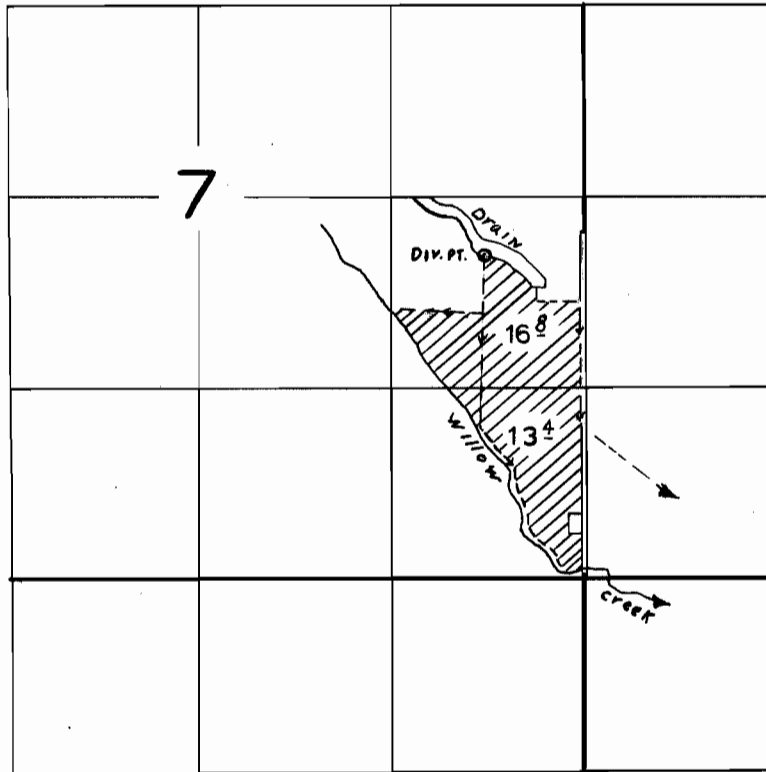

**FINAL PROOF SURVEY**  
UNDER

Application No. 38487 Permit No. 28714  
IN NAME OF

Lawrence R. Mendiola and Dottie Mendiola

Surveyed FEB. 17 1965, by E.W. Eltering