


T. 7 S. R. 2 W. W. M.

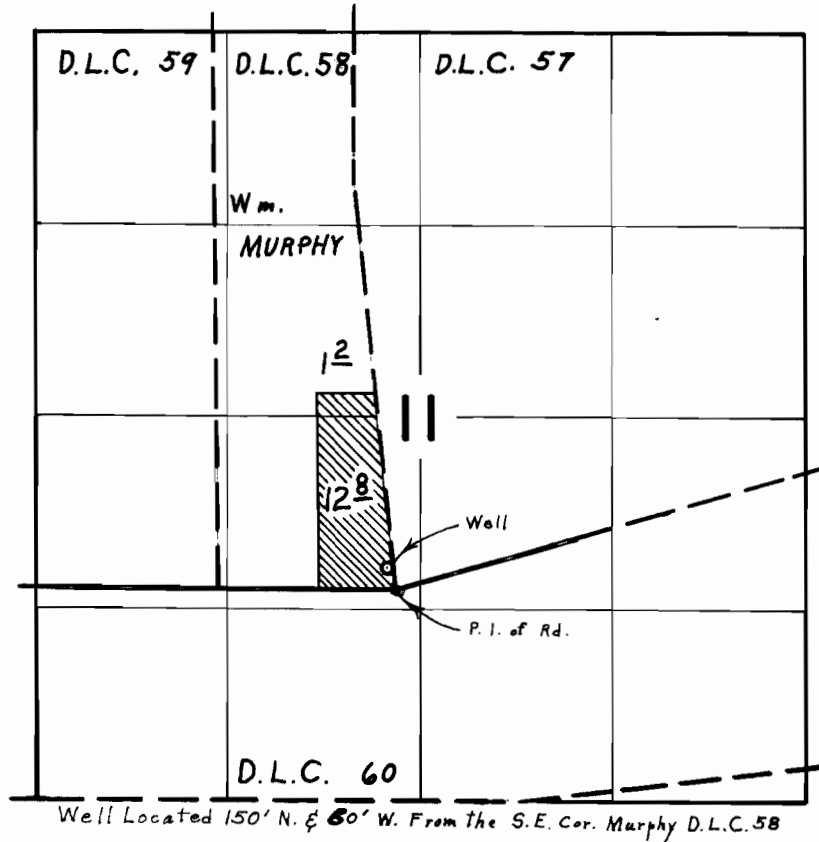

FINAL PROOF SURVEY UNDER

Application No. G-2394 Permit No. G-2208
IN NAME OF

NOAH CECIL ADKINS

Surveyed Aug. 18, 1966, by L. E. Gould