


T.21S.R.4W. W.M.

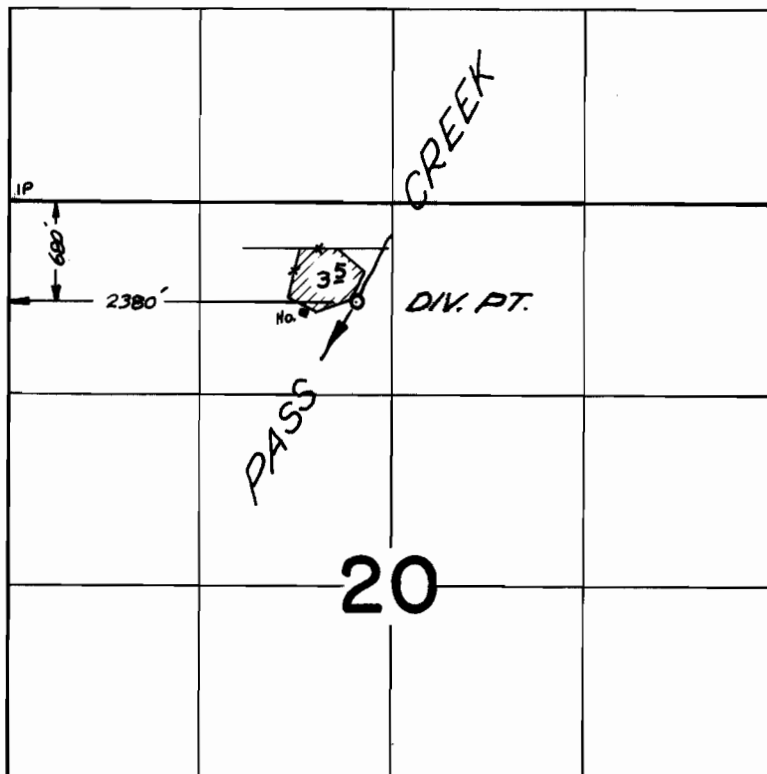

FINAL PROOF SURVEY
UNDER

Application No. 39906 Permit No. 29704
IN NAME OF

ROBERT DERRICK

Surveyed May 18 1966, by V. GARNER