


T.23 S.R.4 W.W.M.

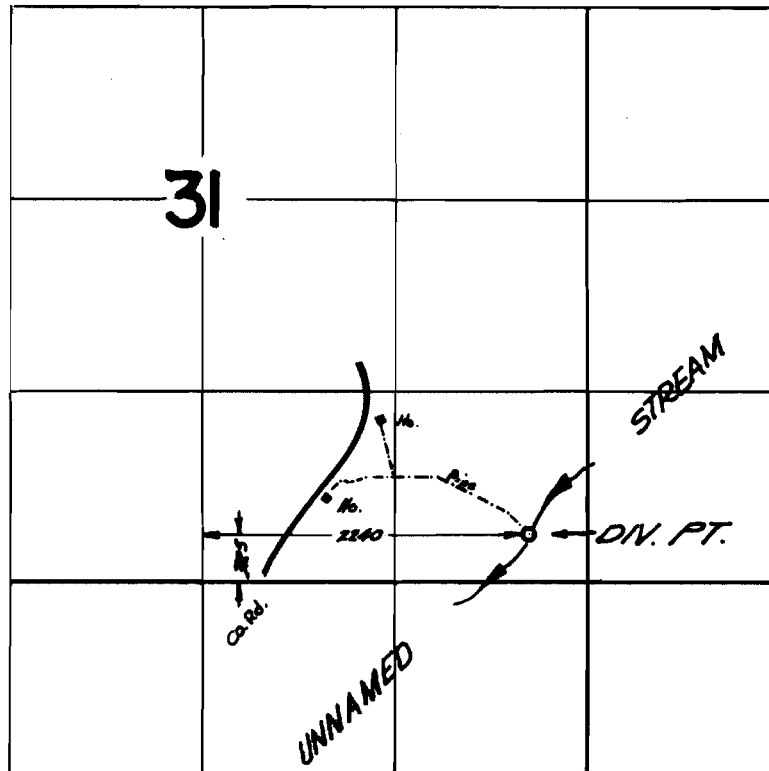

FINAL PROOF SURVEY
UNDER

Application No. 40890 Permit No. 30479
IN NAME OF

LARRY R. and VIVIAN M. FURRER

Surveyed May 18 1966, by V. GARNER