


T.21S.R.4W. W.M.

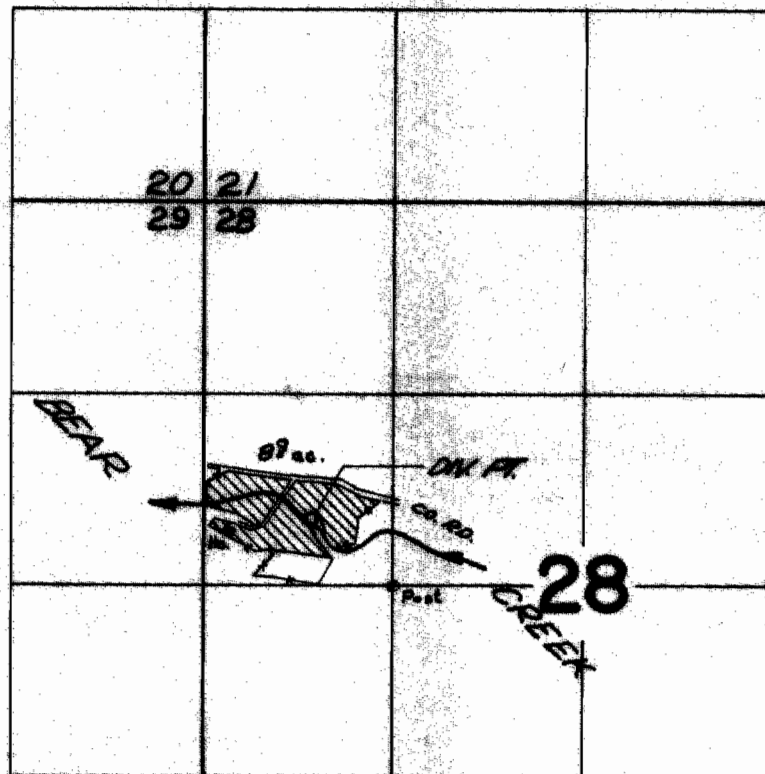

On Pt. located 460 ft. N. / 560 ft. W. from the
S.E. cor. SW $\frac{1}{4}$, NW $\frac{1}{4}$ Section 28

FINAL PROOF SURVEY
UNDER

Application No. 37684 Permit No. 28116
IN NAME OF

ERWIN B. GOINS

Surveyed May 17 1966 by V. GARNER