


T.21S.R.48&5W.W.M.

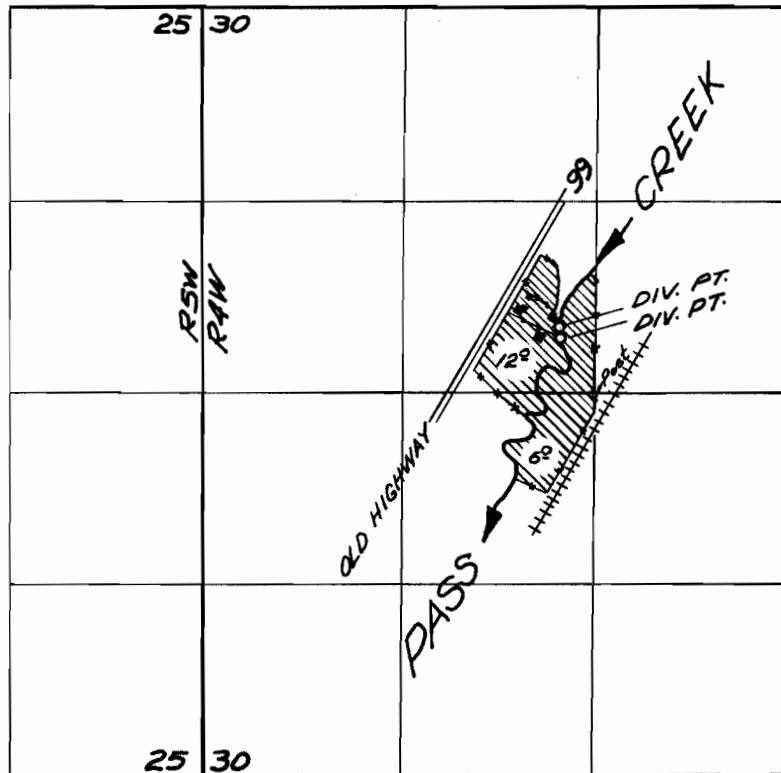

Div. Pts. located 375 ft. N. & 240 ft. W., 450 ft. N. 250 ft. W.
both from the center of section 30

FINAL PROOF SURVEY UNDER

Application No. 3923/ Permit No. 2923/
IN NAME OF

EUGENE and NOMA REMINGTON

Surveyed May 17, 1966, by V. GARNER