


T.14S. R.30E. W.M.

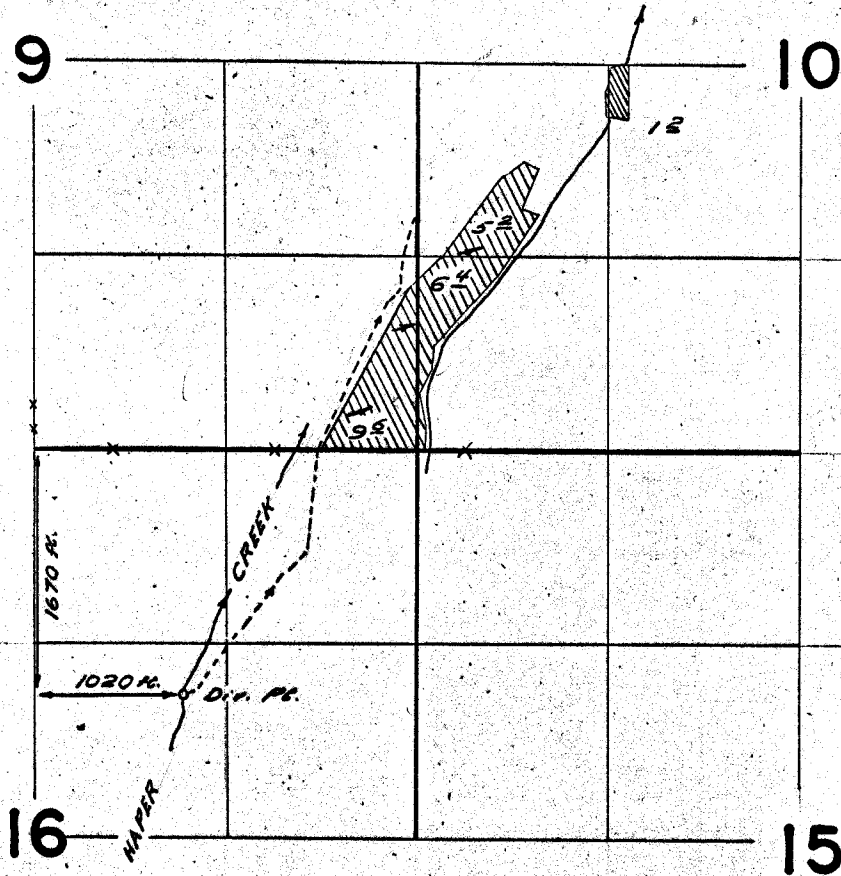

FINAL PROOF SURVEY
UNDER

Application No. 38453 Permit No. 28638
IN NAME OF

DENNIS E. LEMONS

Surveyed June 27 1967, by W. J. Ruppert