


T.36S.R.1 W. W.M.

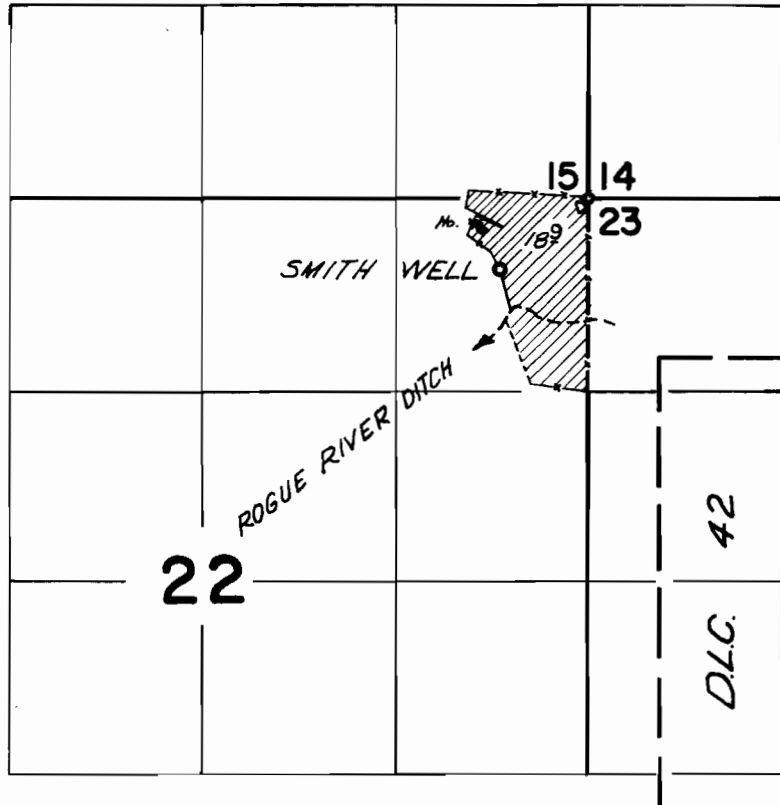

Smith well located 490 ft. South and 600 ft. West from the North East corner of Section 22

FINAL PROOF SURVEY UNDER

Application No. G-2270. Permit No. G-2082
IN NAME OF

DUDLEY POLKIE SMITH, JR.

Surveyed MAY 31, 1966, by V. GARNER.