


T.20S.R.3W.W.M.

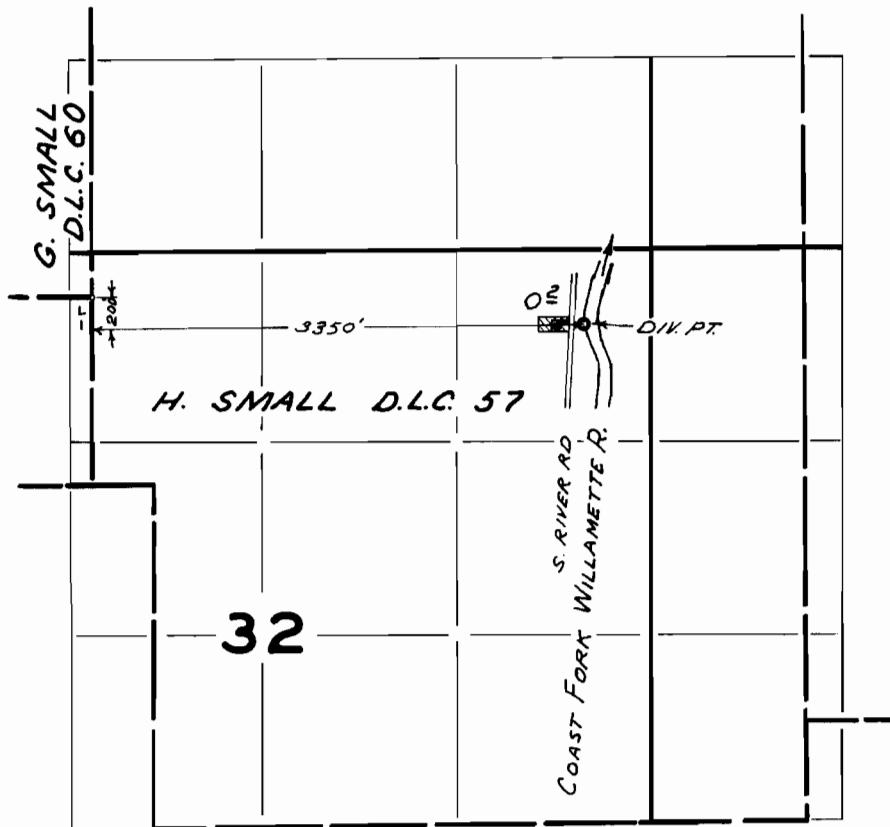

FINAL PROOF SURVEY
UNDER

Application No. 39114 Permit No. 29116
IN NAME OF

CHARLES L. AND VERNA L. HACK

Surveyed *MAY 5* 1965, by *R.H. JACKSON*