


T. 20S. R. 3W. W.M.

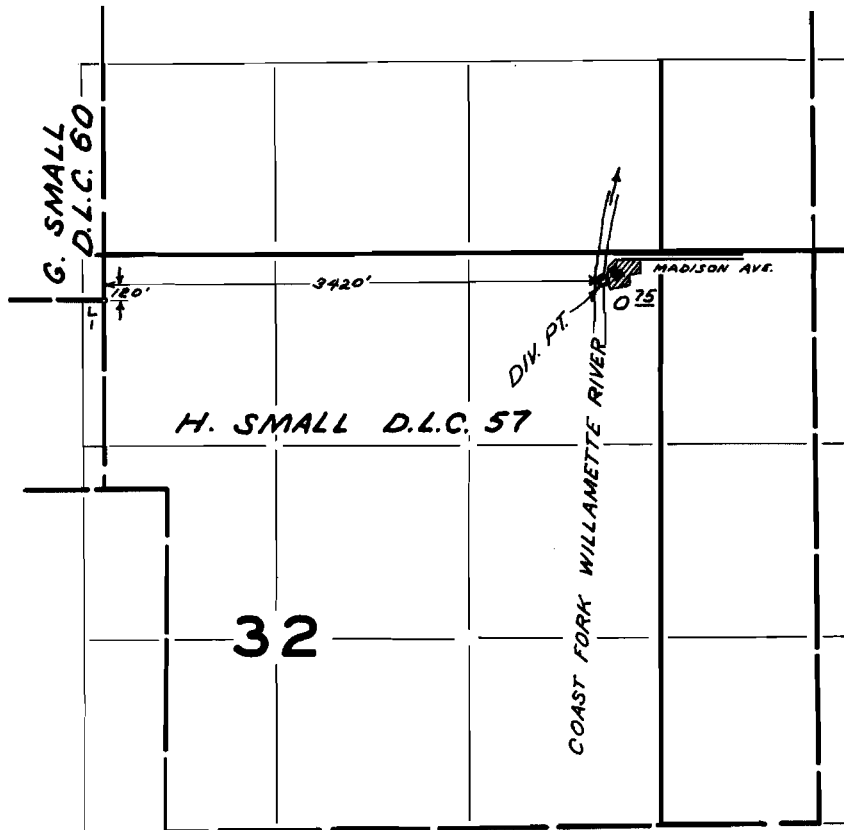

FINAL PROOF SURVEY
UNDER

Application No. 40017 Permit No. 29803
IN NAME OF

HERBERT W. AND WILMA M. LOMBARD, JR.

Surveyed MAY 12 1966, by L. GOULD