


T.16 S. R.2 W. W.M.

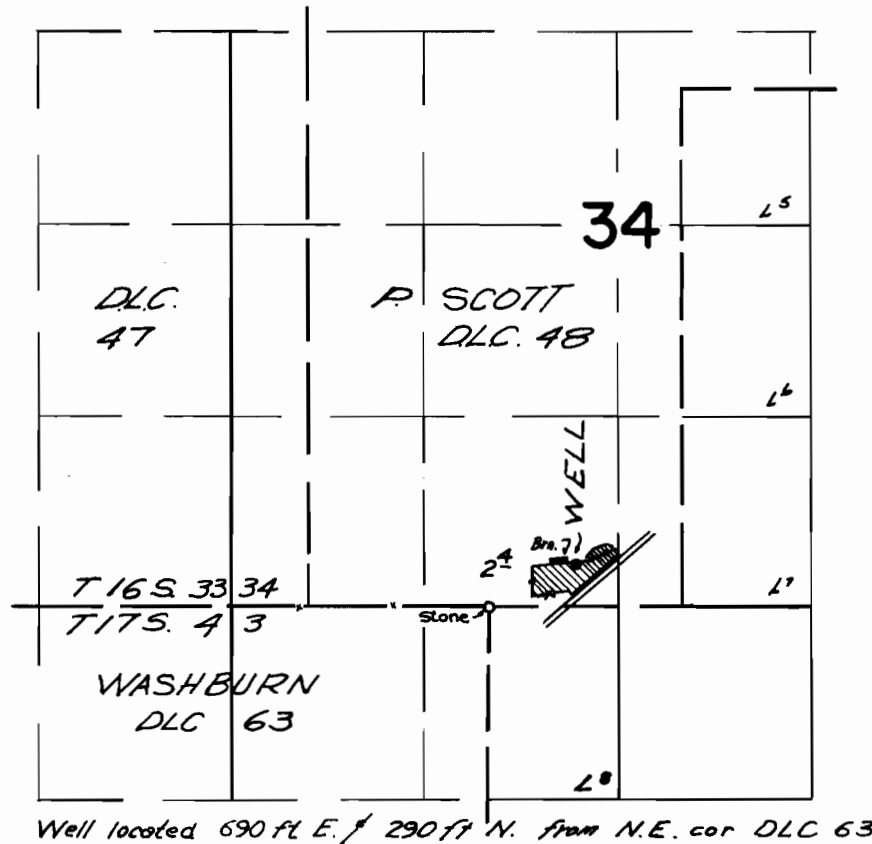

FINAL PROOF SURVEY
UNDER

Application No. 6378 Permit No. 62987
IN NAME OF

FLORIS L. NADEAU

Surveyed May 2, 1966, by V. GARNER