


T. 20 S. R. 3 W. W.M.

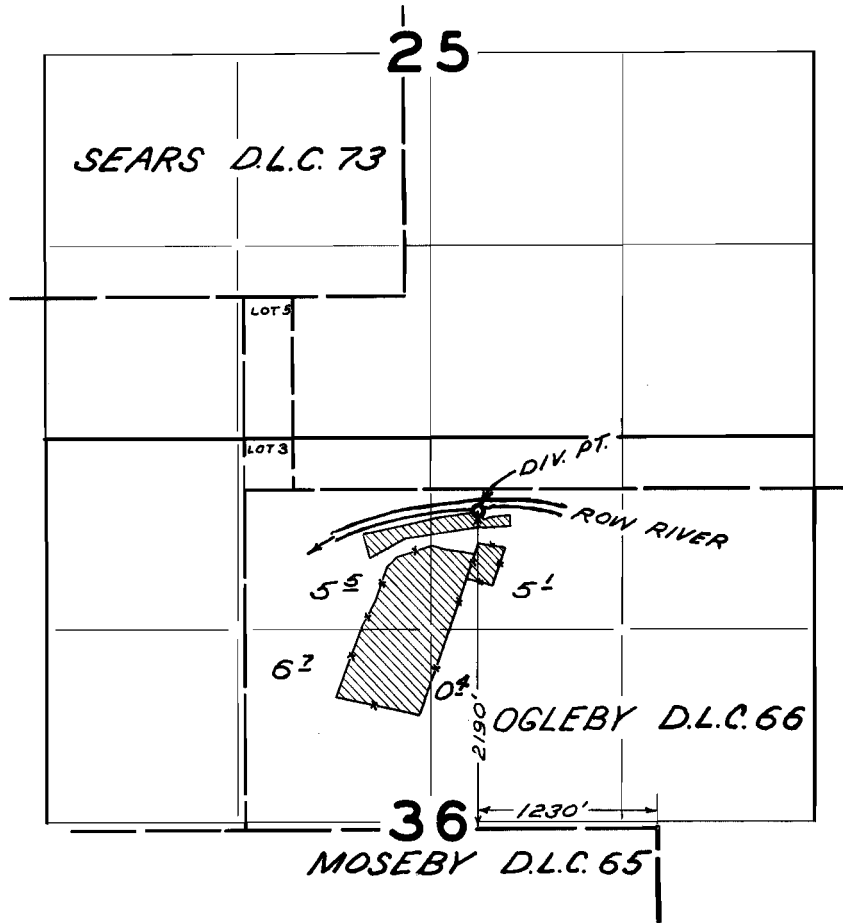

FINAL PROOF SURVEY
UNDER

Application No. 40097 Permit No. 29875
IN NAME OF

ROBERT L. O'RENICK

Surveyed MAY 11, 1966, by L. GOULD