


T. 20 S. R. 3 W. W. M.

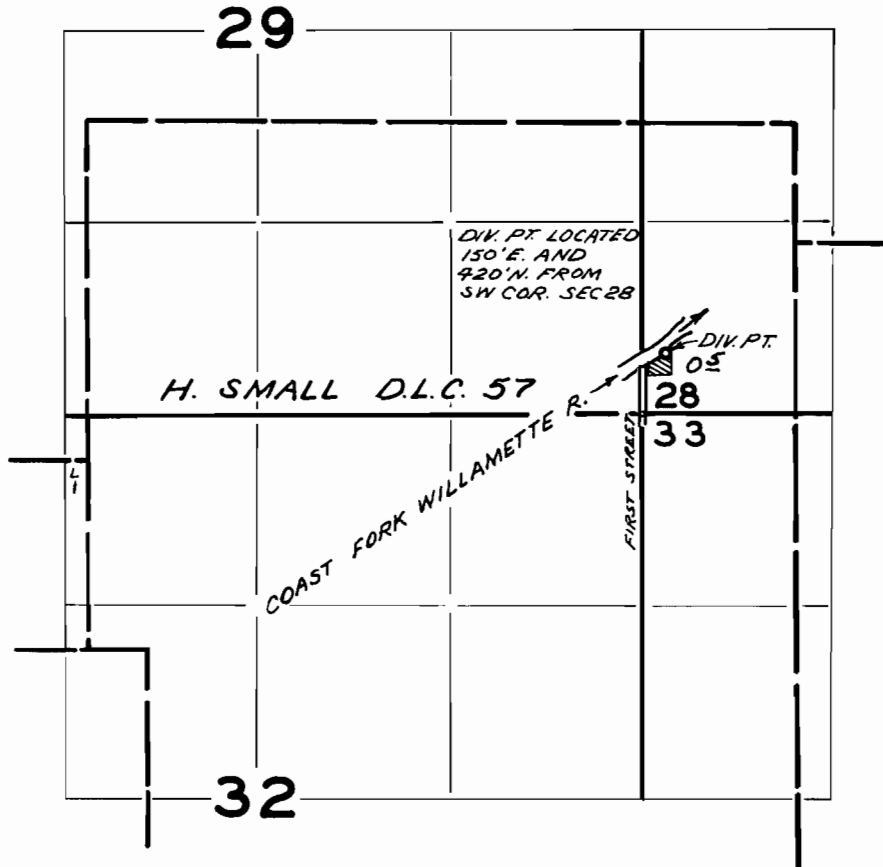

**FINAL PROOF SURVEY**  
UNDER

Application No. 41658 Permit No. 31087

IN NAME OF  
**IVAN E. PATTON AND**  
**BETTY JEAN PATTON**

Surveyed SEP 20 1967, by L. GOULD