


T.17S.R.1W.W.M.

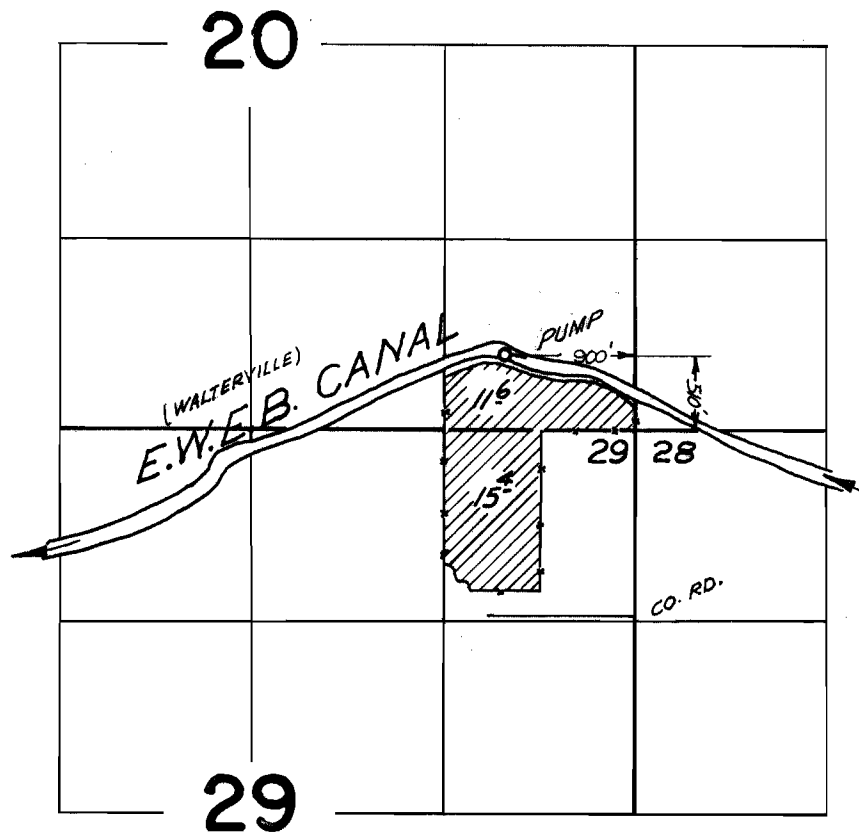

FINAL PROOF SURVEY UNDER

Application No. 33937 Permit No. 26754
IN NAME OF

JACK J. PHILLIPS

Surveyed May 4 1966, by V. GARNER