


# T.17S. R.2W. W.M.

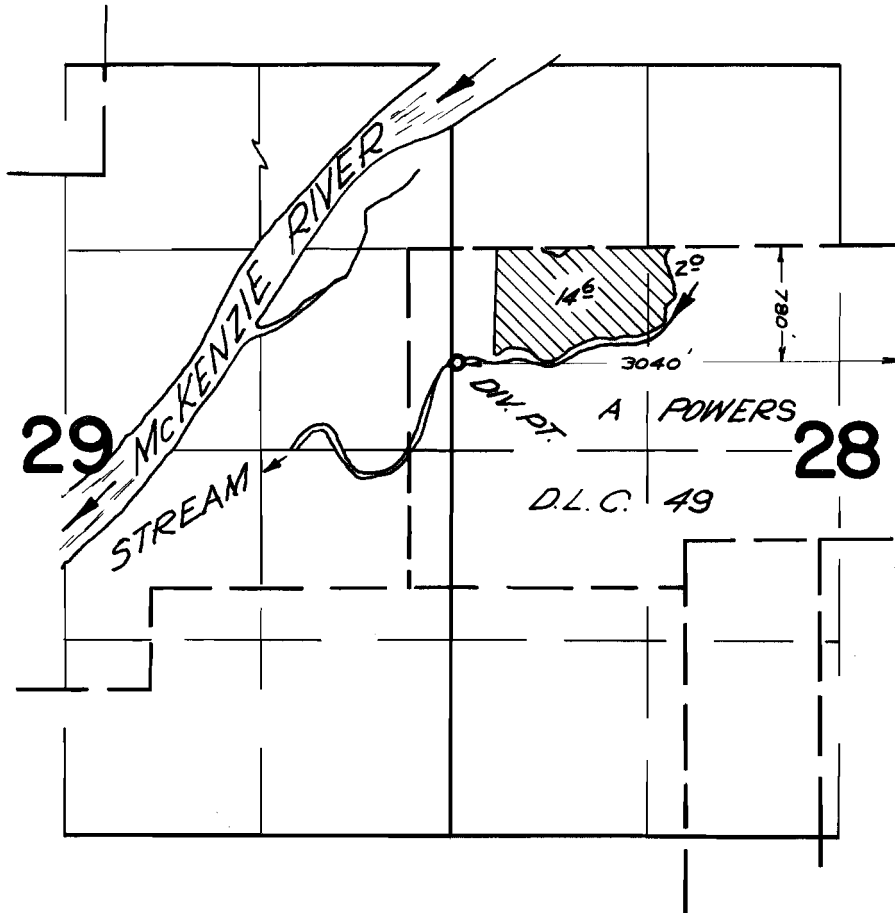

## FINAL PROOF SURVEY UNDER

Application No. 39944 Permit No. 29729  
IN NAME OF

ARTHUR R. QUACKENBUSH

Surveyed May 10 1966, by V. GARNER