
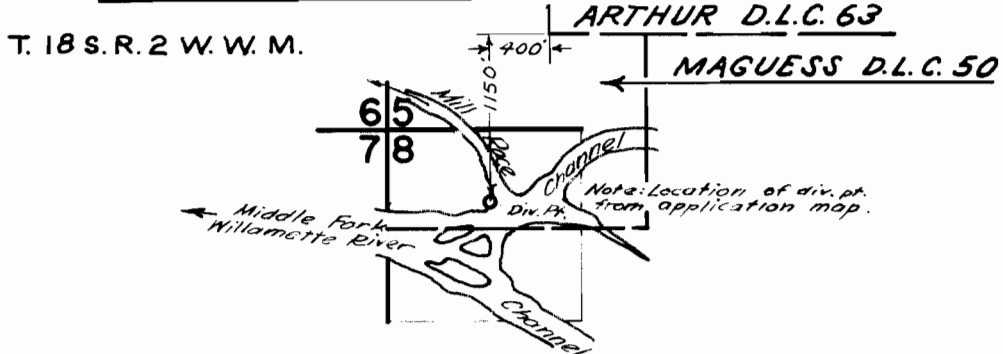


T.18S.R.2&3W.W.M.

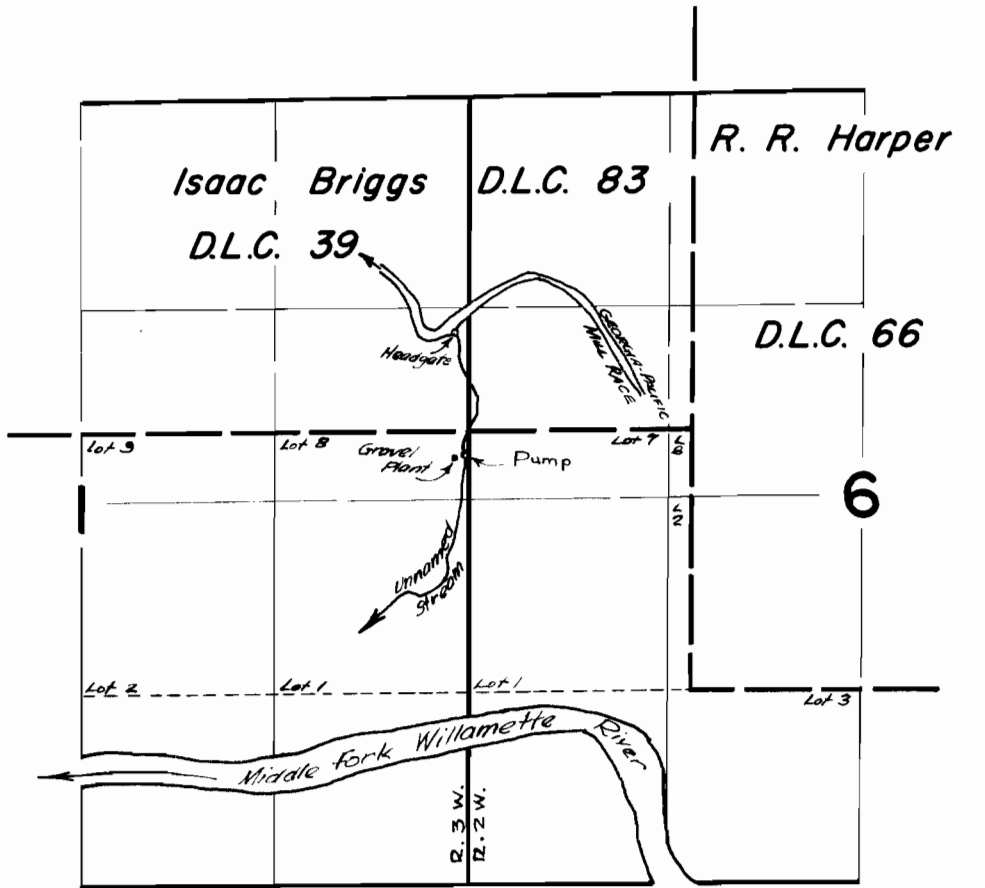

**FINAL PROOF SURVEY**  
UNDER

Application No. 39171 Permit No. 29218  
IN NAME OF  
**SPRINGFIELD SAND & GRAVEL CO.**

Surveyed May 5, 1965, by *R. Jackson*