


T. 10 S. R. 11 W. W.M.

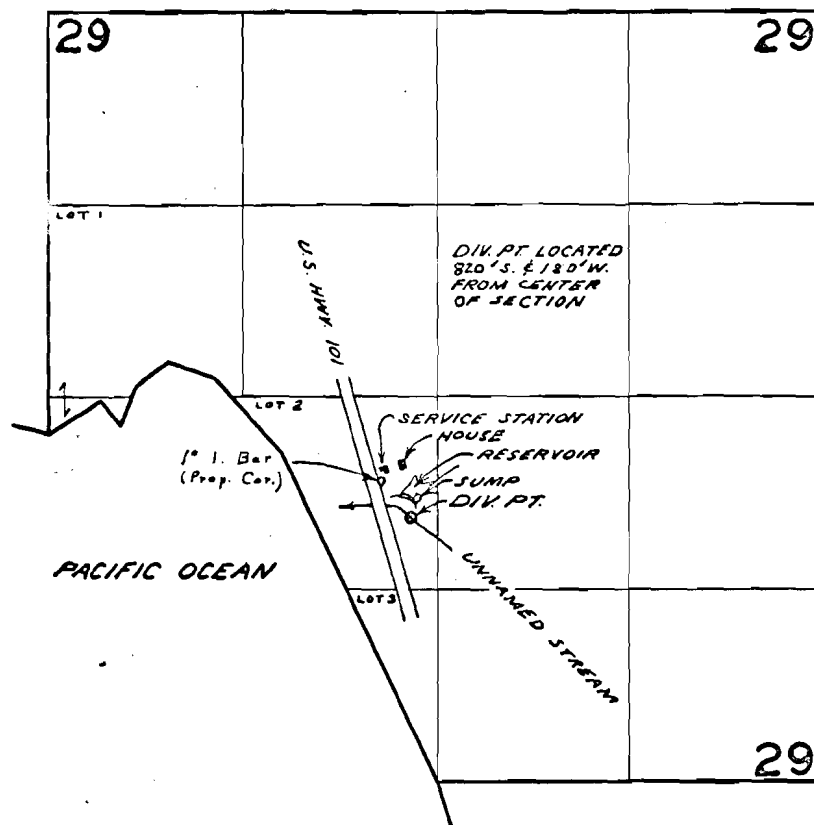

FINAL PROOF SURVEY
UNDER

Application No. ^{R-39123}~~38984~~ Permit No. ^{R-3696}~~29043~~
IN NAME OF

RICHARD & IDA M. HANSEN

Surveyed SEP 23 1966, by L. GOULD