


T.20S.R.3W.W.M.

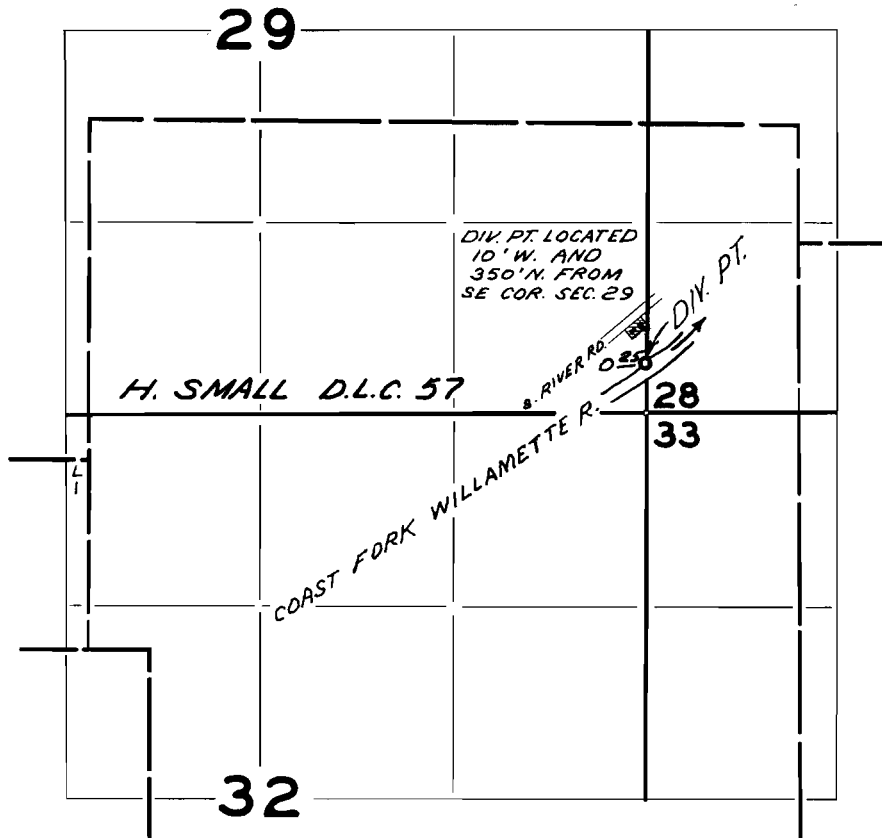

FINAL PROOF SURVEY
UNDER

Application No. 41651 Permit No. 31002

IN NAME OF
SAMUEL P. TUCKER AND
MIRIAM N. TUCKER

Surveyed SEP 20 1967, by L. GOULD