


T. 13 S. R. 11 W. W.M.

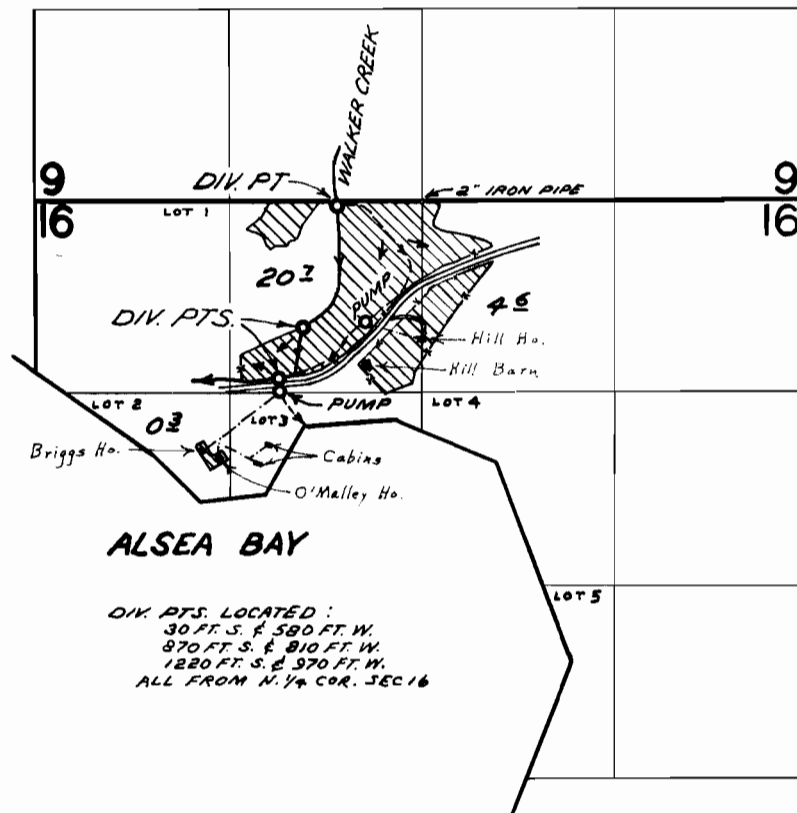

FINAL PROOF SURVEY
UNDER

Application No. 35108 Permit No. 27485
IN NAME OF

ERNEST H. & LOUISE HILL

Surveyed AUG. 25, 1966, by L. GOULD