


T.14S. R.4W. W.M.

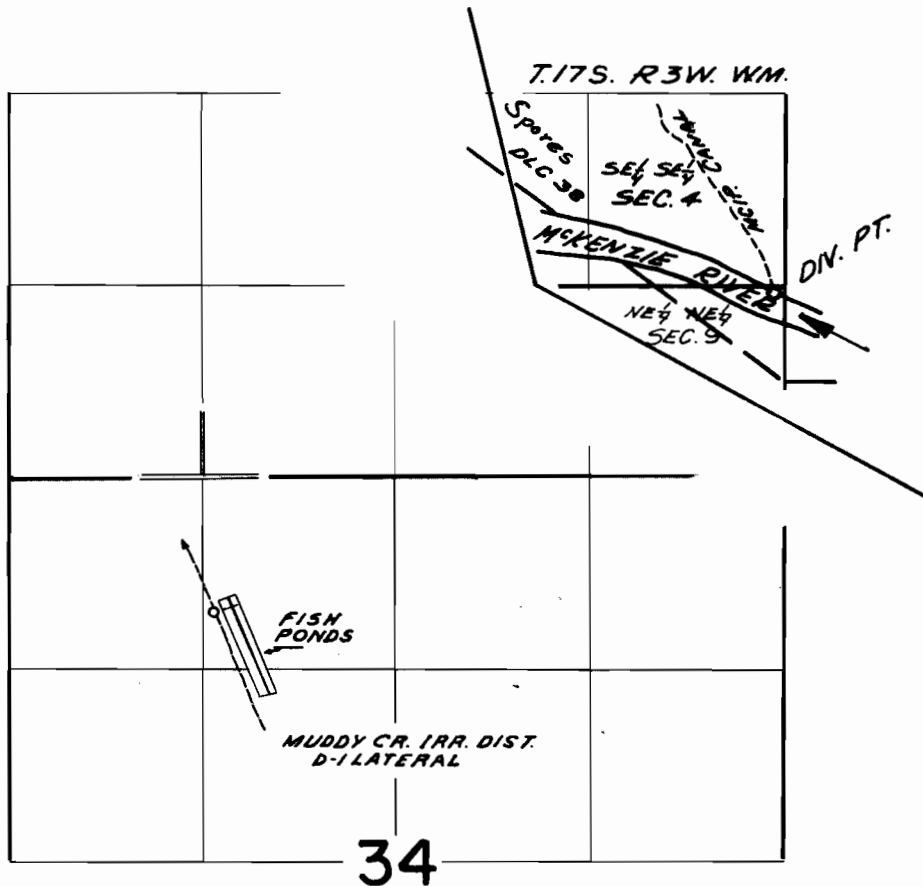

Div. Pt. located 4440 ft. S. + 5250 ft. E. from the S.E. cor. Mansfield D.L.C. #79 (see above detail)

FINAL PROOF SURVEY
UNDER

34936

27585

Application No. R-34935 Permit No. R-2680
IN NAME OF

GERALD K. FALK

Surveyed SEPT 29 1965, by L. COLEBANK