


T.9S.R.2W.W.M.

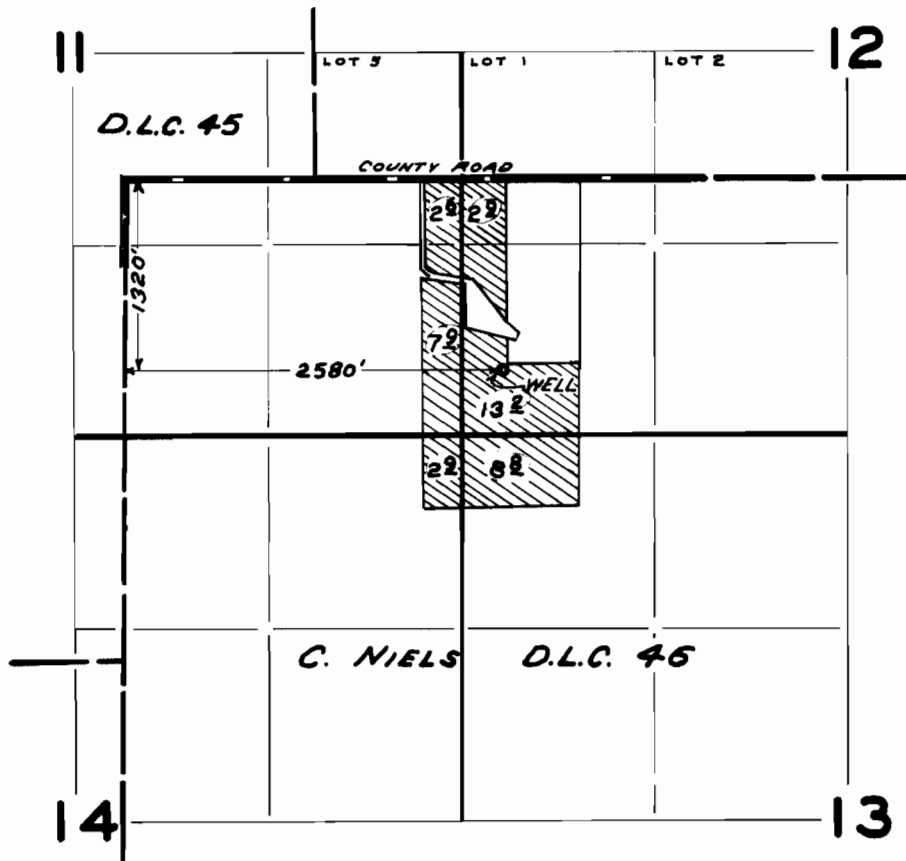

FINAL PROOF SURVEY
UNDER

Application No. G-1771 Permit No. G-1750
IN NAME OF

OHLE A. COOMES

Surveyed JUN. 14 1965, by C. GARDNER