


T.6S. R.1E.W.M.

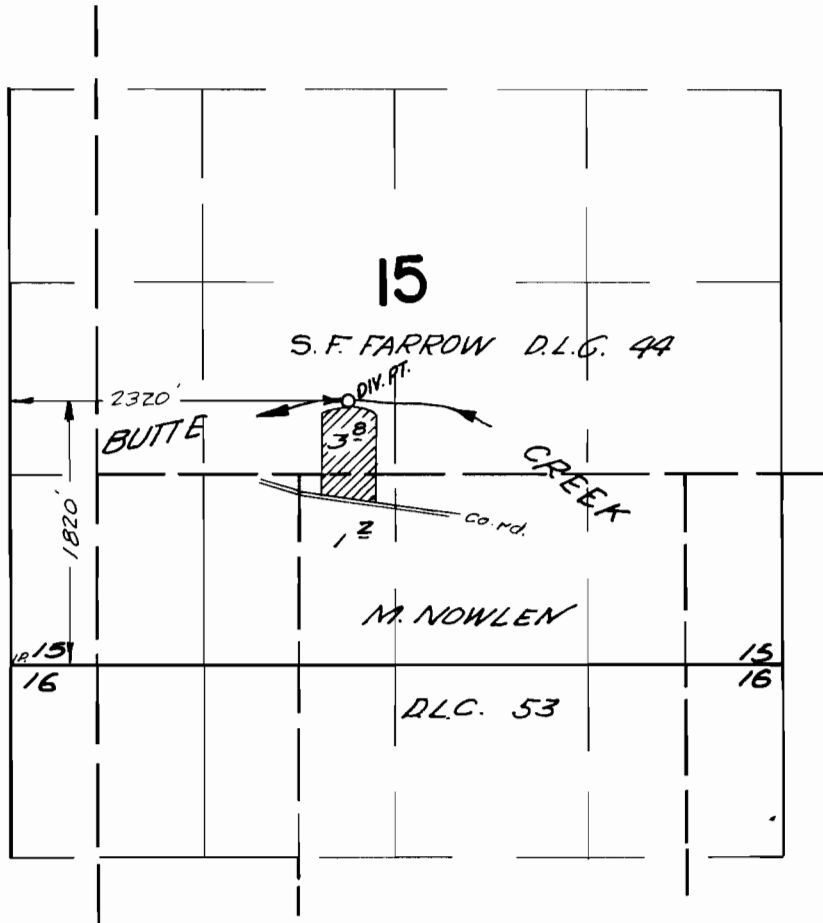

FINAL PROOF SURVEY UNDER

Application No. 35065 Permit No. 27450
IN NAME OF

JOHN M. GIVEN

Surveyed Aug. 16. 1966, by V. GARNER